

KANSAS

Form 51-5M-7-40-Palace


Stafford

Section 27 Township 24 Range 13-W

Well No. #3 McNaghten "B"

Company Atlantic & Phillips

NORTH McNaghten Pool

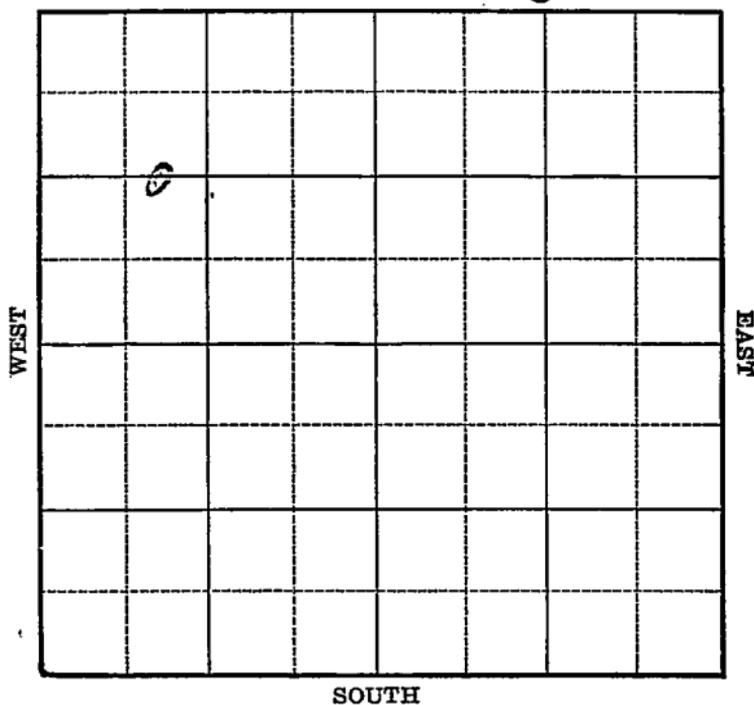

Sec. 27 Twp. 24 R. 13-W

Well No. #3 McNaghten "B" Farm
Atlantic & Phillips Company

(McNaghten)


_____ Ft. from N. Line

1320 Ft. from S. Line

_____ Ft. from E. Line

990 Ft. from W. Line

Elev. 1932

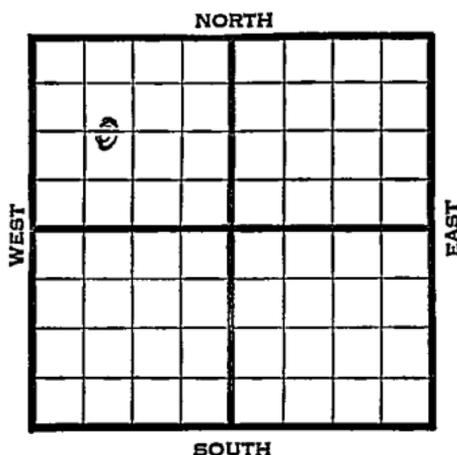

1940	REPORT
11/6	Location
11/14	Derrick.
11/21	Surface hole.
11/27	10" - 424' Drlg. 2725'
12/5	Lans. 3554' SO 3688-90'
	SO 3712-18' SO 3724-35'
	Drlg. 3780'
12/12	Viola 3915' 5" - 4053'
	T.D. 4057' SSO RUST.
12/18	Arb. 4051'
	5" - 4053'
	T.D. 4064'
	2000 acid.
	Depthograph potential 33,357 bbls
	Maximum 3000 bbls.
	37.8 Gravity
	COMPLETED

Map No. 83 Sec. 27 Twp. 24 R. 13WWell No. 3 McNaghten "B"Atlantic & Phillips Company

Contractor

FIRST REPORT

C E L W $\frac{1}{2}$ NW Ft. from N. Line1320 Ft. from S. Line Ft. from E. Line990 Ft. from W. Line

McNaghten Pool

SECTION PLAT

Location XRig up

Drilling and Remarks:

RECORD

Cased in., ft.Sand Gas Oil Total Depth

PRODUCTION

1st 24 hrs. Nat. 1st 24 hrs. after shot Gas Cu. Ft.Dry Hole Abandoned

Date

NOV 6 1940 19

S. J. LEWIS Scout

Map No. 83 Sec. 27 Twp. 24 R. 13WWell No. 3 McNaghten "B"Atlantic & Phillip s Company

Contractor

COMPLETEDC E L W $\frac{1}{2}$ NW Ft. from N. Line1320 Ft. from S. Line Ft. from E. Line990 Ft. from W. Line

MCNAGHTEN POOL

SECTION PLAT

Location Rig up

Drilling and Remarks:

*Cor 4051**5" 4053**2000 acid**Depth 33357**May 3000**32 5 32***RECORD**Cased in., ft.Sand Gas Oil Total Depth 4064**PRODUCTION**1st 24 hrs. Nat. 1st 24 hrs. after shot Gas Cu. Ft.Dry Hole Abandoned

Date

DEC 18 1940 19

S. J. LEWIS

Scout