

O. W. P. B.
KANSAS


Stafford

FORM 51 5M BR1X

Section 27 Township 24 Range 14W

Well No. 2 Ne 111

Company Atlantic

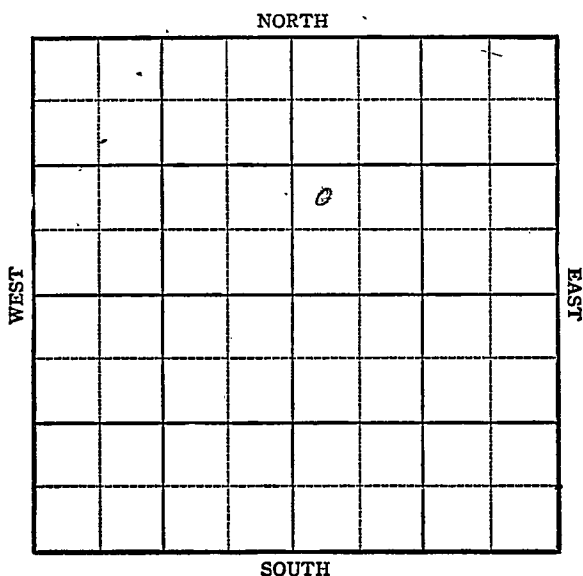

KANSAS

Stafford **O. W. P. B.**

Sec. 27 Twp. 24 R. 14W ✓

Well No. #2, Neill Farm

Atlantic Company

Richland


 Ft. from N. Line

990 Ft. from S. Line

 Ft. from E. Line

330 Ft. from W. Line

Elev. 1976

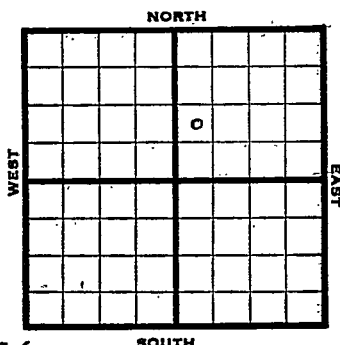

1944

REPORT

6/14 Location

6/21 Rotary

6/28 8" @ 882
Drilling 2170

7-12 Drilling 4107'
Lans 3659'

7-19 Viola 4115'
Simp 4156'
Arb. 4197'
TD 4209'
5" at 4200'
RUST

8/2 Arb 4197'
5" @ 4200'
TD 4209'.
Depth Pot 806 -
Gravity 37.9

COMPLETED

O. W. P. B.

D & A TD 3880'

KC 3659' Miss 4029' Simp. 4161'

Arb. 4201' OTD 4209' 5" @ 4200'

PB 4185' 12/4176-79 12/4168-71

B/1 BWPH 500 A B/20 GO 2 GWPH

1000 A B/1 GO 10 GWPH PB 3880'

28/3820-27 500 A S/3 BWPH

50,000 CFG. D & A

FIRST REPORT

ABANDONED

1951
12/12

Pool Name Richland**KANSAS**Map No. 27 Sec. 24 Twp. 14WWell No. 2 NeillAtlantic

Company

FIRST REPORT

Contractor

NW SW NE**SECTION PLAT**

		0	

Ft. from N. Line

990

Ft. from S. Line

Ft. from E. Line

330

Ft. from W. Line

Stafford CountyLocation X

Rig up

Drilling and Remarks:

RECORD

Cased _____ in., _____ ft.

Sand _____

Gas _____

Oil _____

Total Depth _____

PRODUCTION

1st 24 hrs. Nat. _____

1st 24 hrs. after shot _____

Gas _____ Cu. Ft.

Dry Hole _____

Abandoned _____

Date

JUN 14 1944

19

S. J. LEWIS

Scout

KANSAS

Pool Name RichlandMap No. 83 Sec. 27 Twp. 24 R. 14WWell No. 2 NeillAtlantic

Company

COMPLETED

Contractor

NW SW NE

SECTION PLAT

		0	

Ft. from N. Line

990

Ft. from S. Line

Ft. from E. Line

330

Ft. from W. Line

Stafford County

Location

Rig, up

Drilling and Remarks:

*Cr 4197**5' C 4200**Depth 806**37 E*

RECORD

Cased _____ in., _____ ft.

Sand _____

Gas _____

Oil _____

Total Depth 4209

PRODUCTION

1st 24 hrs. Nat. _____

1st 24 hrs. after shot _____

Gas _____ Cu. Ft.


Dry Hole _____

Abandoned _____

Date

AUG 2 1944 19

S. J. LEWIS Scout

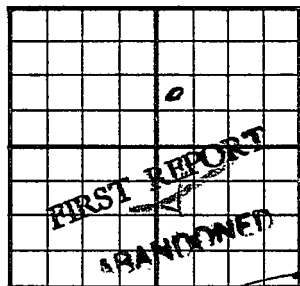County Stafford State KansasSec. 27 (Blk. Twp.) 24 (Sur. Rge.) 14W Map No.Operator Atlantic Ref.Well No. 2 Farm NeillElev. 1976 Location NW SW NE990 Ft. From S Line NE330 Ft. From W Line Quarter1st. Report DEC 1 2 1951

Completion

Remarks OWPBO. W. P. B.~~NO RECORD~~
Spudding DateDrlg. Data D & A TD 3880 Richland PoolKC 3659 Miss. 4029 Simp. 4161Arb. 4201 OTD 4209 5" @ 4200PB 4185 12/ 4176-79 12/ 4168-71B/ 1 bwph 500 A B/ 20 go 2 gwph1000 A B/ 1 go 10 gwph PB 388028/ 3820-27 500 A S/ 3 bwph 50,000 cfbD & A~~NO RECORD~~J. E. TYRA