FORM 51 25M 3-49 PETROL

KANSAS

Stafford

Section 27 Township 24 Range 15W

Well No. #1 Campbell

Company Westgate-Greenland

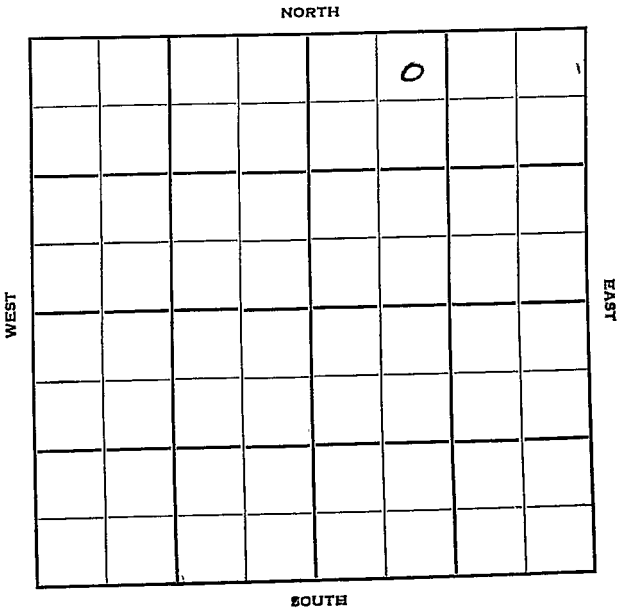

FORM 252-B

Stafford

KANSAS ✓

Sec. 27 Twp. 24 R. 15W

Well No. #1 Campbell Farm

Westgate-Greenland Company

W-G Contr. Contractor

330 Ft. from N. Line

____ Ft. from S. Line

____ Ft. from E. Line

990 Ft. from W. Line

NE NW NE

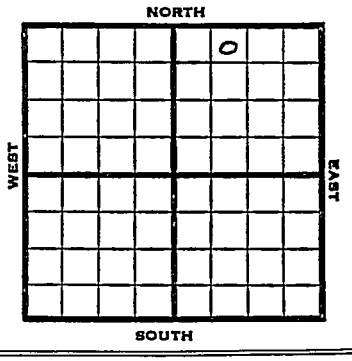

1953	Elev. 2027' REPORT
3/18	Spudded 3/15/53 8" @ 200 Drlg. 750
3/26	Drlg. 3820'
4/2	Drlg 4509'
4/8	Spud 3-15-53 D & A TD 4516 8" @ 200 Anhy 987' Heeb 3611 Br. lime 3751 Lans. 3763 B KC 4026 Kh. 4156 Miss. 4137 DST 4158-78 open 1 hr. rec 25' mud 540# Viola 4235 DST 4236-59 open 1 hr. rec 45' SO & GCM, 20' VHO & GCM 750# Simp. 4384 Arb. 4491 TD 4516' D & A ABANDONED

FORM 275 FOR SALE BY KANSAS BLUE PRINT CO.

County Stafford State Kansas

Sec. 27 (Blk. Twp.) 24 (Sur. Rge.) 15W Map No.

Operator Westgate-Greenland

Well No. 1 Farm Campbell

Elev. Location NE NW NE

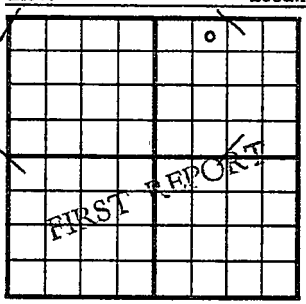

330 Ft. From N Line NE

990 Ft. From W Line Quarter

1st. Report MAR 18 1953

Completion

Remarks W-G - Contr.

Spudding Date 3-15-53

Drlg. Data

8" @ 200 drlg. 750

J. G. McGEHEE

FORM 275 FOR SALE BY KANSAS BLUE PRINT CO.

County Stafford State Kansas

Sec. 27 (Blk. Twp.) 24 (Sur. Rge.) 15W Map No.

Operator Westgate-Greenland

Well No. 1 Farm Campbell

Elev. 2027 Location NE NW NE

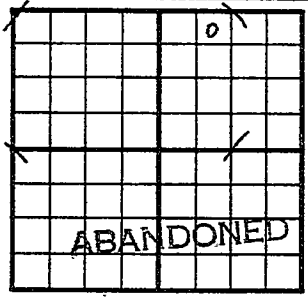

330 Ft. From N Line NE

990 Ft. From W Line Quarter

1st. Report

Completion APR 8 1953

Remarks

W-G - Contr.

Spudding Date 3-15-53

Drlg. Data D & A TD 4516

8" @ 200 Anhy 987 Heeb. 3611

Br. lime 3751 Lans. 3763 B KC 4026

Kh. 4156 Miss. 4137 DST 4158-78

open 1 hr. Rec. 25' mud 540#

Viola 4235 DST 4236-59 open 1 hr.

Rec. 45' so & gcm 20' vho & gcm 750#

Simp. 4384 Arb. 4491 TD 4516

D & A

J. G. McGEHEE