

KANSAS


FORM 51 25M 3-49 PETROL

Stafford

Section 27 Township 24 Range 15W

Well No. 1 Campbell

Company Crown Oil Et al

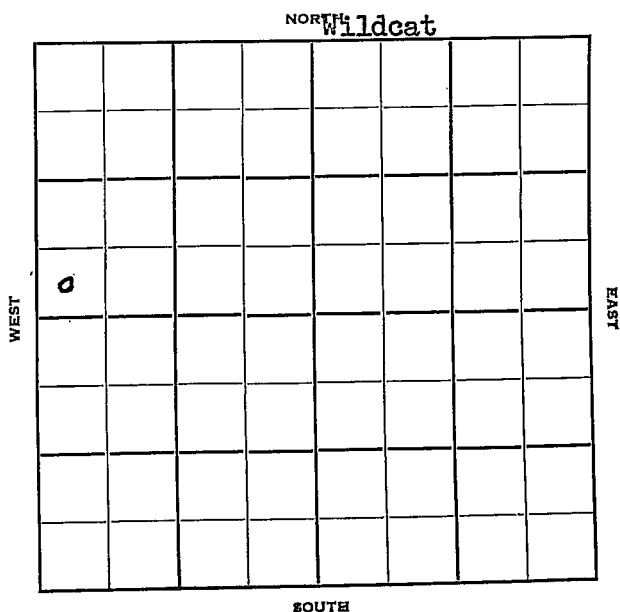

KANSAS

Stafford

✓ 15W

Sec. 27 Twp. 24 R. 15W

Well No. #1 Campbell Farm

Crown Oil et al

Company

Wildcat

Ft. from N. Line

330'


Ft. from S. Line

Ft. from E. Line

330'

Ft. from W. Line

SW NW

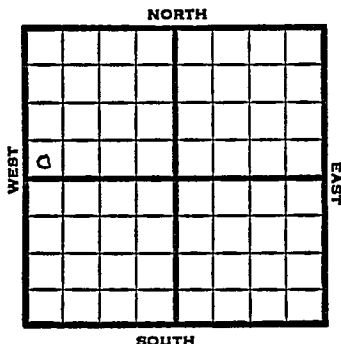

194 Elev 2033' **REPORT**

4/20 Surface Hole
4/27 8" @ 415'
Drlg. 3028'
5/4 Lansing 3801'
Drlg. 4120'
5/10 Miss 4206'
Kinderhook 4246'
5" @ 4230'
5/18 "
5/25 "
6/1 "
6/7 "
6/15 "
6/21 "
6/28 Viola 4311'
Drlg. 4323'
7/6 "
7/13 TD 4323'
Viola 4311'
band.

ABANDONED

Map No. _____ Sec. 27 Twp. 24 R. 15W

Well No. 1 Campbell

Crown Oil etal. Company

FIRST REPORT Contractor

SW NW

SECTION PLAT

o			

_____ Ft. from N. Line

330 Ft. from S. Line

_____ Ft. from E. Line

330 Ft. from W. Line

Stafford County

Location _____

Rig up _____

Drilling and Remarks:

surface hole

RECORD

Cased _____ in., _____ ft.

Sand _____

Gas _____

Oil _____

Total Depth _____

PRODUCTION

1st 24 hrs. Nat. _____

1st 24 hrs. after shot _____

Gas _____ Cu. Ft.

Dry Hole _____

Abandoned _____

Date _____

APR 20 1949

19

S. J. LEWIS Scout

Map No. K 83 Sec. 27 Twp. 24 R. 15W

Well No. 1 Campbell


Crown Oil et al. Company

ABANDONED

Contractor

SW NW

E 1,2633
SECTION PLAT

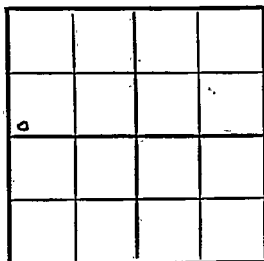

 Ft. from N. Line

330 Ft. from S. Line

 Ft. from E. Line

330 Ft. from W. Line

Stafford County

RECORD

Location

Cased in., ft.

Rig up

Sand

Drilling and Remarks:

Gas

Wells 4311

Oil

Total Depth 4928

PRODUCTION

1st 24 hrs. Nat.

1st 24 hrs. after shot

Gas Cu. Ft.

Dry Hole

Abandoned

Date

JUL 13 1949 19

S. J. LEWIS Scout