


Section 27 Township 24 Range 15-W

Well No. #1 Dykes

Company M B Armer
Farmington

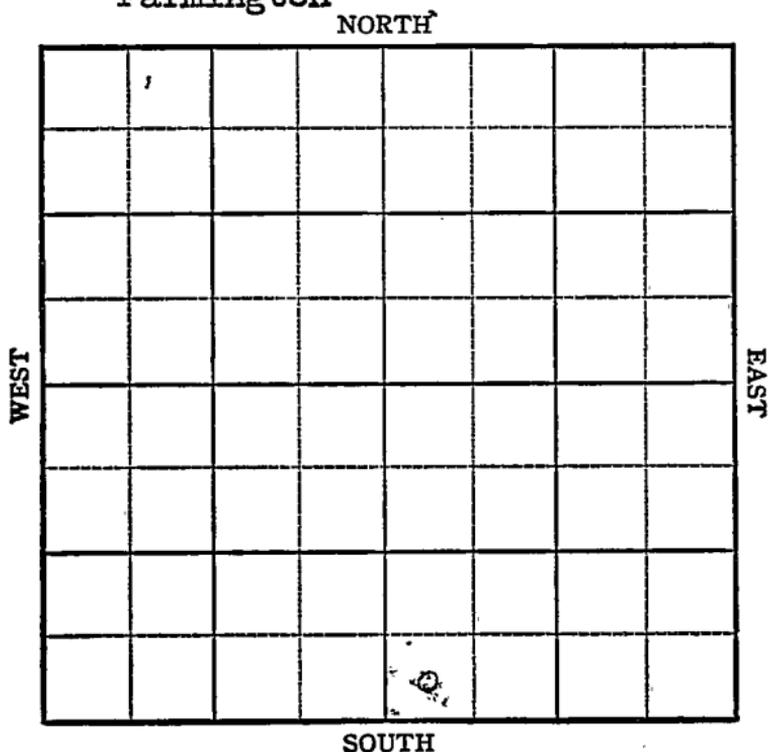

Sec. 27 Twp. 24 R. 15-W ✓

Well No. #1 Dykes Farm _____

M B Armer Company _____

Farmington


_____ Ft. from N. Line

330 Ft. from S. Line

_____ Ft. from E. Line

330 Ft. from W. Line

SW SE

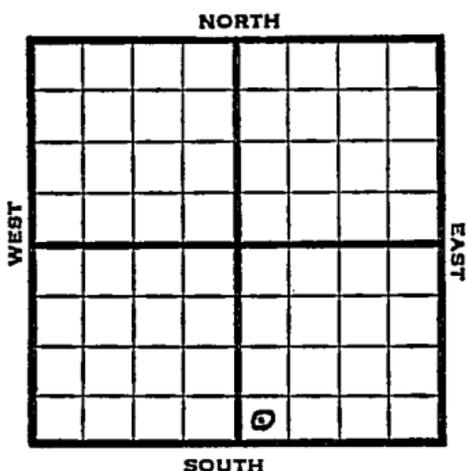

1948 Eli 2025' REPORT

10/13 RUR

10/19 8" @ 186'
Drlg. 2003'

10/26 Drlg. 3472'

11/3 Drlg 4112'

11/10 TD 5462'

Lans. 3770'

Miss 4177'

Viola 4279'

Simp 4414'

Aband.

ABANDONED

Map No. _____ Sec. 27 Twp. 24 R. 15W

Well No. 1 Dykes

M. B. Armer Company

FIRST REPORT Contractor

SW SE


SECTION PLAT

_____ Ft. from N. Line

330 Ft. from S. Line

_____ Ft. from E. Line

330 Ft. from W. Line

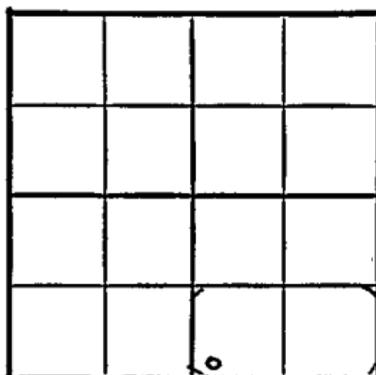

Stafford County

Location _____

Rig up _____

Drilling and Remarks:

R U R

RECORD

Cased _____ in., _____ ft.

Sand _____

Gas _____

Oil _____

Total Depth _____

PRODUCTION

1st 24 hrs. Nat. _____

1st 24 hrs. after shot _____

Gas _____ Cu. Ft.

Dry Hole _____

Abandoned _____

Date

OCT 13 1948 19

S. J. LEWIS Scout

Kansas

Farmington Pool

Map No. 83 Sec. 27 Twp. 24 R. 15WWell No. 1 DykesM. B. Armer Company**ABANDONED**

Contractor

SW SE

*E. 2025***SECTION FLAT** Ft. from N. Line330 Ft. from S. Line Ft. from E. Line330 Ft. from W. Line

Stafford County

Location Rig up

Drilling and Remarks:

*Lease 3770**Mine 4177**Vidba 4277**Smy 4414***RECORD**Cased in., ft.Sand Gas Oil Total Depth 4462**PRODUCTION**1st 24 hrs. Nat. 1st 24 hrs. after shot Gas Cu. Ft.Dry Hole Abandoned

Date

NOV 10 1948 19

S. I. LEWIS

Scout