


Section 27 Township 24 Range 15W

Well No. 1 Campbell

Company Crown Oil

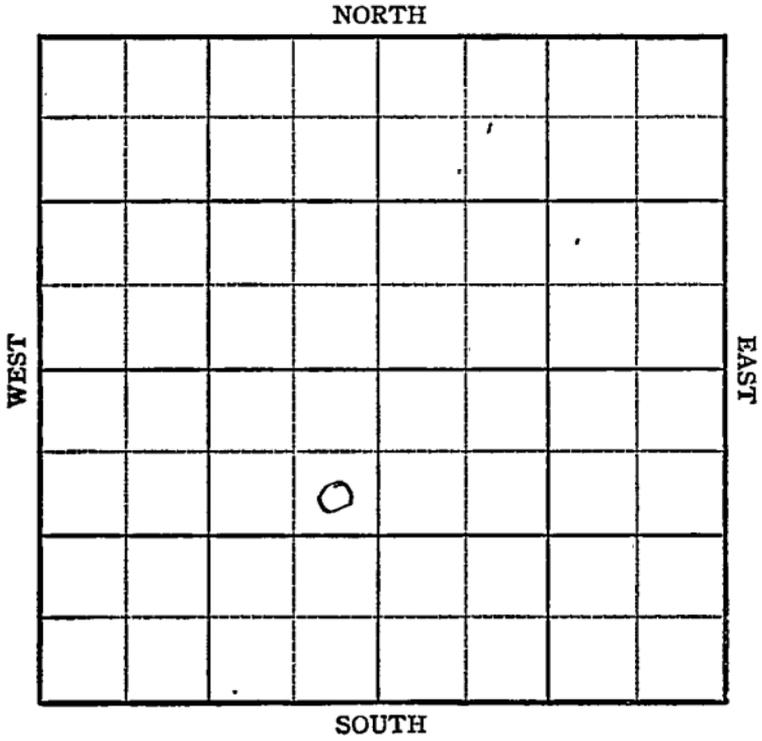

Sec. 27 Twp. 24 R. 15-W

Well No. #1 Campbell Farm

Crown Oil Company
Faemington Pool


990 Ft. from N. Line

 Ft. from S. Line

330 Ft. from E. Line

 Ft. from W. Line

SE NE SW

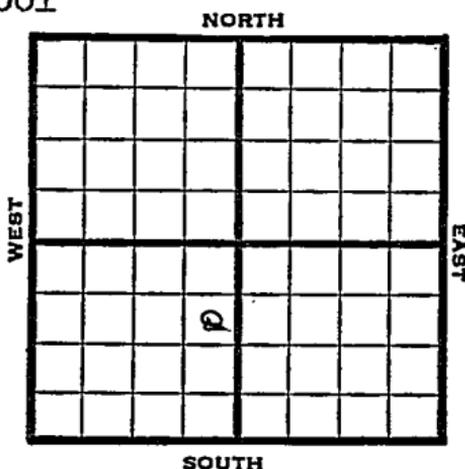

1948 Eli 2026' REPORT

- 8/4 RUR
- 8/11 8" @ 628'
Drlg 2340'
- 8/18 Drlg 3673'
- 8/25 Lansing 3790'
Mississippi 4192'
Viola 4299'
Drlg 4310'
- 9/1 TD 4395'
PB 4250
5" @ 4207'
- 9/8 "
- 9/15 Miss 4192'
Viola 4299'
TD 4395'
5" @ 4207'
PB 4237'
4,588,000 Gas
Comp

COMPLETED

Stafford County Kansas State

Map No. _____ Sec. 27 Twp. 24 R. 15W

Well No. 1 Campbell

Crown Oil Company

FIRST REPORT

Contractor _____

SE NE SW

SECTION PLAT

990 Ft. from N. Line

_____ Ft. from S. Line

330 Ft. from E. Line

_____ Ft. from W. Line

Farmington Pool

Remarks:

R U R

Date

AUG 4 1948

Scout

S. J. LEWIS

Stafford County Kansas State

Map No. 83 Sec. 27 Twp. 24 R. 15W

Well No. 1 Campbell

Crown Oil Company

COMPLETE

Contractor

SE NE SW


E 1.2026
SECTION PLAT

990 Ft. from N. Line

 Ft. from S. Line

330 Ft. from E. Line

 Ft. from W. Line

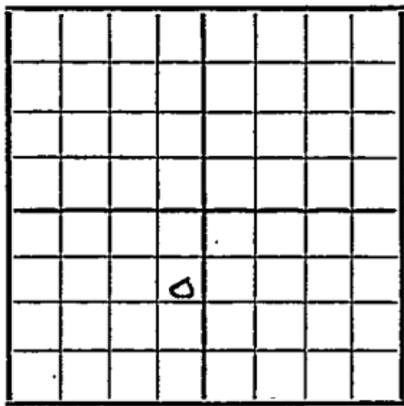

Farmington Pool

Remarks:

Miss 4192

Vista 4289

W 4395

5" 4207

PS 4227

4,588,000 Gas

Date
SEP 15 1948

Scout
S. J. LEWIS