


Section 27 Township 24 Range 16WWell No. #1 FisherCompany ~~Morrison Drilling et al~~ BRANINE & HOLLA.

NORTH

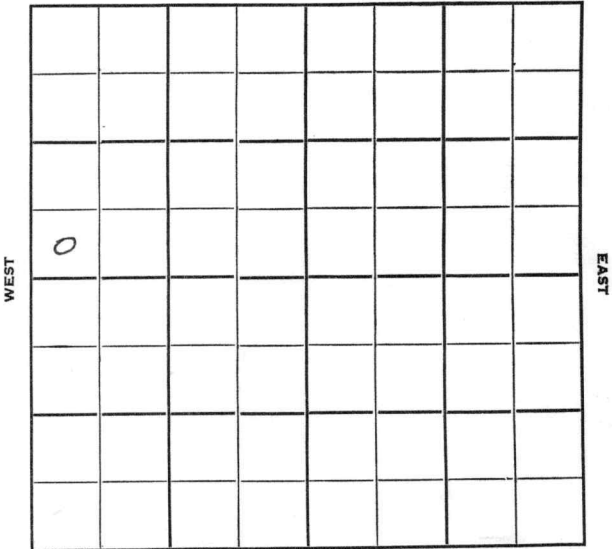

SOUTH

O.W.W.O. Edwards

KANSAS

Sec. 27 Twp. 24 R. 16W

Well No. #1 Fisher Farm

BRANINE & HOLL
Morrison Drig. et al Company

Herndon

Contractor


Wildcat

Ft. from N. Line

330' Ft. from S. Line

Ft. from E. Line

330' Ft. from W. Line
SW SW NW

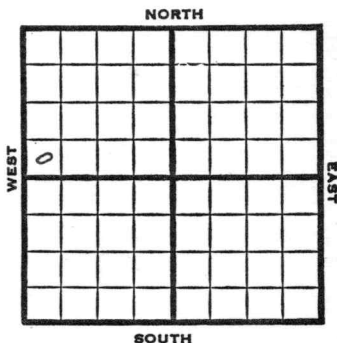

1951

Elev. 2277'
2077'

REPORT

3/7

MIM

4/4

Spud 3-7-51
D&A TD 4727
8" @ 300' Anhy 1040
Top. 3346' Heeb. 3691
Dodge 3722 Br lime 3840
KC 3846 SSO 3848-49 3935-38
4023-29 4037-41
Cong. 4270 Miss 4280
Kinderhook 4309 Viola 4402
Simp. 4598 Arb. 4671
TD 4727
D&A

2077
1040
1037

ABANDONED

O.W.W.O.

1955

1/5


KC 3846'
cong 4260', Miss 4270' Arb. 4671'
OTD 4727'
to test Miss. for gas.

5/25

KC 3846; Cong 4260; Miss 4270; Arb
4671; OLD INFO: OTD 4727; was D&A
NEW INFO: 5" 4320; 48/4268-74; frac
50/4280-90; frac; 560,000 cfg; 1000 A
test 600,000 cfg; sd frac; 25,000 cfg
D&A

ABANDONED

J. E. TYRA

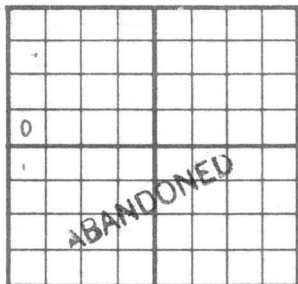County Edwards State KansasSec. 27 (^{Blk.}_{Twp.}) 24 (^{Sur.}_{Rge.}) 16W Map No.Operator Morrison Drlg. etal.Well No. 1 Farm FisherElev. 2277 Location SW SW NW330 Ft. From S Line NW330 Ft. From W Line Quarter1st. ReportCompletion APR 4 1951Remarks WildcatSpudding Date 3-7-51Drlg. Data D & A TD 47278" @ 300 Anhy 1040 Top. 3346Heeb. 3691 Dodge 3722 Br. lime 3840KC 3846 SSO 3848-49 3935-38 4023-294037-41 Cong. 4270 Miss. 4280Kinderhook 4309 Viola 4402 Simp. 4598Arb. 4671 TD 4727D & A

O.W.W.O.

County Edwards State Kansas
 Sec. 27 (Blk.) 24 (Sur.) 16W Map No.
 Operator Bramine & Holl
 Well No. 1 Farm Fisher
 Elev. 2077 Location SW SW NW

0

FIRST REPORT

330 Ft. From S Line NW
330 Ft. From W Line Quarter
 Ist. Report IAN 5 1955
 Completion O.W.W.O.
 Remarks O.W.W.O.
Herndon - Contr.
 Spudding Date

Drlg. Data Wildcat
KC 3846 Cong. 4260 Miss. 4270
Arb. 4671 OTD 4727 to test Miss. for gas

FABEN GILSTRAP