

Finney KANSAS

Section 27 Township 24 Range 34 W


Well No. # 27 Brown

Company Northern Natural Gas

NORTH

WEST

EAST

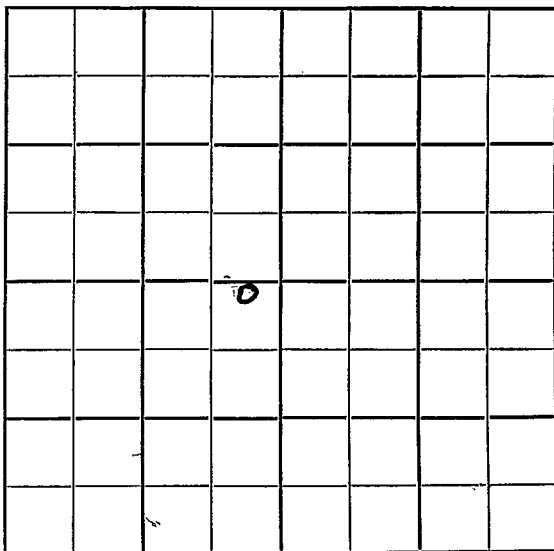

SOUTH

Sec. **27** Twp. **24** R. **34W**Well No. **#27 Brown** Farm**Northern Natural Gas** Company

Contractor

100


Ft. from N. Line


Ft. from S. Line

200

Ft. from E. Line

Ft. from W. Line

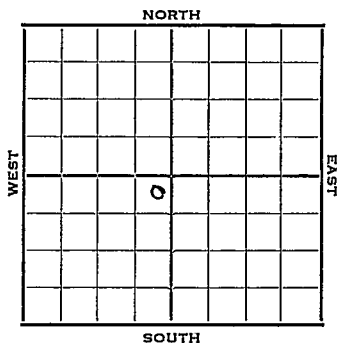NE NE SW**1952****Elev. 2963' REPORT****6/11****MIR****6/18****10" @ 443 H****Drlg. 2190'****6/25****7" @ 2428' RTD 2445'****7/2****NR****7/9****DD 2500' 6000 A****Drlg. 2550'****7/17****TD 2709' 289' of 5" liner 21000 A****7/23****Spud 6-12-52****Gas Well TD 2709' 10" @ 443****7" @ 2428' TD 2500' DD 2709****Her. 2445 Kri. 2474****Odell 2527 Win. 2537****Ft. Riley 2597 21000 A****Comp. 9,828,000 gas. 396#****COMPLETED**

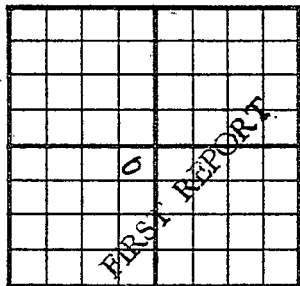County Finney State KansasSec. 27 (Blk. Twp.) 24 (Sur. Rge.) 34W Map No.Operator Northern Natural GasWell No. 27 Farm BrownElev. _____ Location NE NE SW100 Ft. From N Line SW200 Ft. From E Line Quarter1st. Report JUN 11 1952

Completion _____

Remarks _____

Spudding Date _____

Drlg. Data _____

MTR


J. G. McGEHEE

County Finney State Kansas
 Sec. 27 (Blk.) 24 (Sur.) 34W Map No.

Operator Northern Natural Gas

Well No. 27 Farm Brown

Elev. 2963 Location NE NE SW

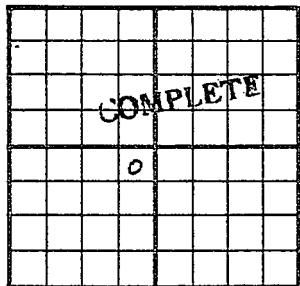

100 Ft. From N Line SW

200 Ft. From E Line Quarter

Ist. Report

Completion JUL 23 1952

Remarks

Spudding Date 6-12-52

Drlg. Data Gas well TD 2709

10" @ 443 7" @ 2428 TD 2500 DD 2709

Her. 2445 Kri. 2474 Odell 2527

Win. 2537 Ft. Riley 2597 21000 A

Comp. 9,828,000 gas 396#

J. G. McGUIRE