


Section 28 Township 24 Range 5-W


Well No. 1 Yoder

Company salt City Gas

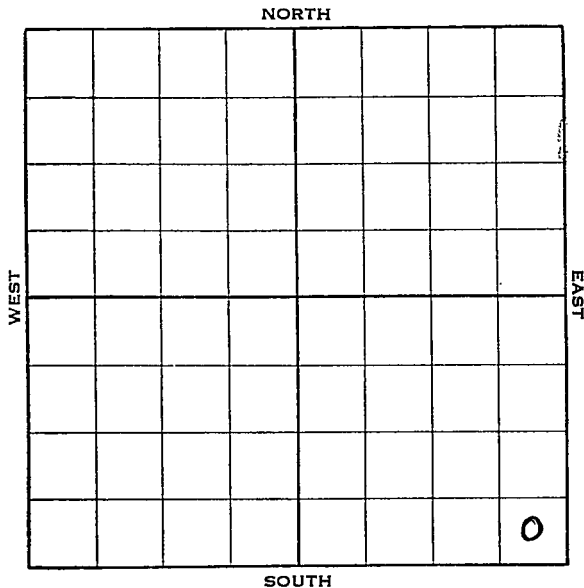

Sec. 28 Twp. 24 R. 5-WWell No. #1 Yoder Farm
Salt City Gas Company Ft. from N. Line330 Ft. from S. Line330 Ft. from E. Line Ft. from W. Line

Elev. 1541

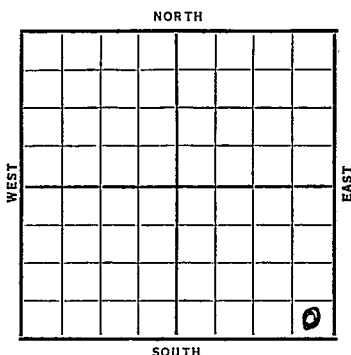

Date

REPORT

1938

3/9 Location

3/18 "

3/25 R. R.

4/1 10" @ 508'.

WOC.

4/8 Drlg. 1858'.

4/15 Drlg. 2930'.

4/22 Chat 3391'. T.D. 3403'.

6" @ 3400'. No shows Rept.

RUST.

4/29 T.D. 3457'. 3½ M gas.

Acidizing.

5/4 6" @ 3400'.

Chat 3391'.

T.D. 3457'.

2000 acid.

Est. 10 M gas.

COMPLETED

Map No. 40 Sec. 28 Twp. 24 R. 5WWell No. 1 YoderSalt City Gas

Company

Contractor

FIRST REPORT

SECTION PLAT

SE/C

 Ft. from N. Line330 Ft. from S. Line330 Ft. from E. Line Ft. from W. Line

			0

Location XRig up

Drilling end Remarks:

RECORD

Cased in., ft.Sand Gas Oil Total Depth

PRODUCTION

1st 24 hrs. Nat. 1st 24 hrs. after shot Gas Cu. Ft.Dry Hole Abandoned

Date

MAR 9 - 1938

19

H. D. Hatfield

Scout

Map No. 40 Sec. 28 Twp. 24 R. 5W

Well No. 1 Yoder

Salt City Gas Company

Contractor

COMPLETED

SE/C

SECTION PLAT

			0

_____ Ft. from N. Line

330 Ft. from S. Line

330 Ft. from E. Line

_____ Ft. from W. Line

Location _____

Rig up _____

Drilling and Remarks:



RECORD

Cased 6 in., 3400 ft.

Sand Chat 3391

Gas _____

Oil _____

Total Depth 3457

PRODUCTION

1st 24 hrs. Nat. _____

1st 24 hrs. after shot _____

Gas _____ Cu. Ft.

Dry Hole _____

Abandoned _____

Date

MAY 4 - 1938 19

H. D. Hatfield Scout