


Section 28 Township 24 Range 12W

Well No. #1 Fortner

Company Lewis Drlg.

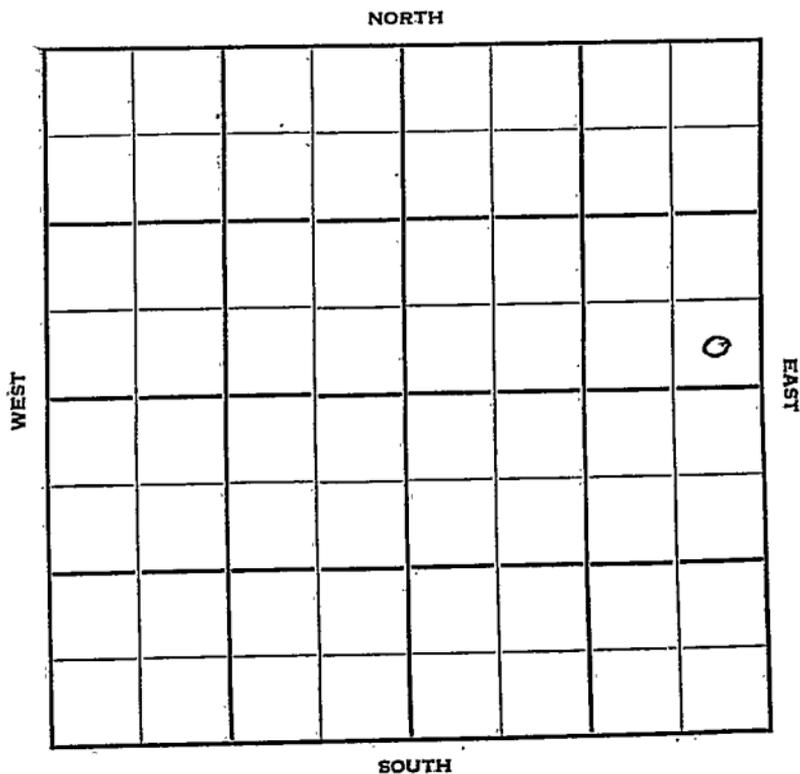

Sec. 28 Twp. 24 R. 12W

Well No. #1 Fortner Farm

Lewis Drlg. Company

" Contractor


Ft. from N. Line

330 Ft. from S. Line

330 Ft. from E. Line

Ft. from W. Line

SE SE NE

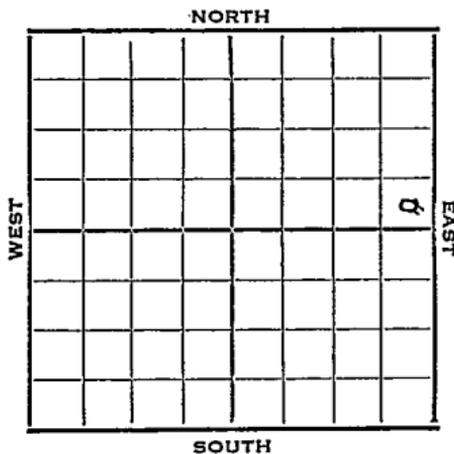

1952 Elev. 1880' REPORT

9/24 Spud 9-18-52
8" @ 284'
Anhy 695'
Drlg. 2540'

10/1 Heeb. 3361 Tor 3378
Douglas 3402 Br Li 3517
KC 3539 KH 3864
V 4019
Drlg. 4031

10/8 Spud 9-18-52
D & A TD 4037'
8" @ 284' Anhy 695' Heeb 3361'
Tor. 3378' Doug. 3402' Br. li 3517'
KC 3539' Kh. 3864' Viola 4019'
TD 4037' D & A

ABANDONED

