


Section 28 Township 24 Range 13-W

Well No. 1 Lyons

Company Atlantic & Phillips

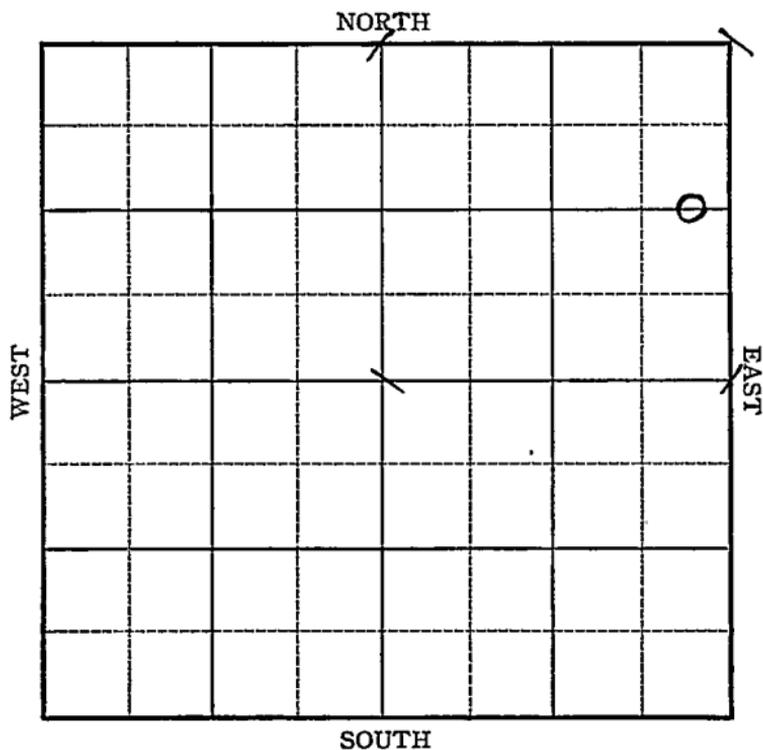


Sec. 28 Twp. 24 R. 13-WWell No. #1 Lyons FarmAtlantic & Phillips Company1320 Ft. from N. Line

_____ Ft. from S. Line

330 Ft. from E. Line

_____ Ft. from W. Line

Elev. 1935'

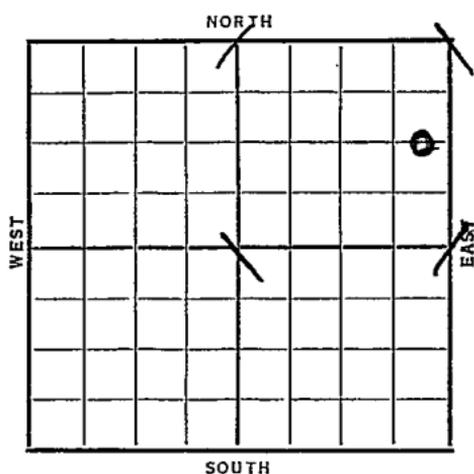

Date	REPORT
1938	
1/5	R U R
1/14	12" @ 412'. Anhy 780'. Drlg. 1760'.
1/20	Drlg. 3400'
1/28	K.C. 3564' Sm. S.O. 3600-05' Cong. 3900' Viola 3910' Drlg. 4064' No shows Rept.
2/4	Arb. 4072' T.D. 4097' 7" - 4072' 3800' oil
2/9	7" @ 4072'. Arb. 4072'. T.D. 4079'. Potential 2039 bbls. Nat.
	COMPLETED

Map No. 83 Sec. 28 Twp. 24 R. 13WWell No. 1 LyonsAtlantic & Phillips Company

Contractor

COMPLETED**C E L N E**1320 Ft. from N. Line

_____ Ft. from S. Line

330 Ft. from E. Line

_____ Ft. from W. Line

SECTION PLAT

			•
			○

Location _____

Rig up _____

Drilling and Remarks:

POT 2039
NOT

RECORDCased 7 in., 4072 ft.Sand Arb 4072

Gas _____

Oil _____

Total Depth 4079**PRODUCTION**

1st 24 hrs. Nat. _____

1st 24 hrs. after shot _____

Gas _____ Cu. Ft.

Dry Hole _____

Abandoned _____

Date

FEB 9 193819H. D. Hatfield Scout