

KANSAS


FORM 51 5M 2-38 TPCO.

Stafford

Section 28 Township 24 Range 13-W

Well No. 2 Lyons

Company Atlantic & Phillips

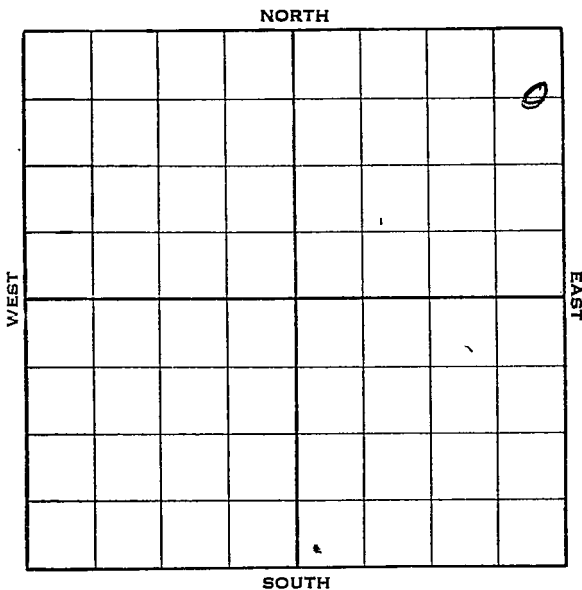


Sec. 28 Twp. 24 R. 13-WWell No. #2 Lyons FarmAtlantic & Phillips Company660 Ft. from N. Line

Ft. from S. Line

330 Ft. from E. Line

Ft. from W. Line

Elev. 1934

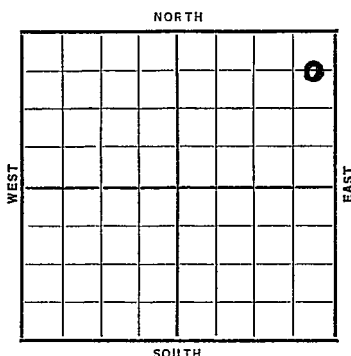

Date	REPORT
1938	
6/22	Location
7/1	"
7/8	Drlg. 360'.
7/15	10" - 454'. Anhy 750'.
	Dlg. 2000'.
7/22	Lans. 3543'. Dlg. 3618'.
7/29	B. K. C. 3845'. Viola 3965'.
	Dlg. 4060'.
8/5	Arb. 4112 & 7".
	T. D. 4116'. 1000' oil in 3 hrs.
8/10	7" - 4112'.
	Arb. 4112'.
	T. D. 4116'.
	Pump 133 bbls. 4 hrs. & 93 bbls.
	4 hours.
	Potential 557 bbls.
	COMPLETED

Stafford KANSAS

Map No. 783 Sec. 28 Twp. 24 R. 13WWell No. 2 LyonsAtlantic & Phillips Company

Contractor

FIRST REPORT

C E L N E N E

660 Ft. from N. Line Ft. from S. Line330 Ft. from E. Line Ft. from W. Line

SECTION PLAT

			0
		1	

Location XRig up

Drilling and Remarks:

RECORD

Cased in., ft.Sand Gas Oil Total Depth

PRODUCTION

1st 24 hrs: Nat. 1st 24 hrs. after shot Gas Cu. Ft.Dry Hole Abandoned

Date

JUN 22 1900 19H. D. Hatfield

Scout

Map No. 83 Sec. 28 Twp. 24 R. 13WWell No. 2 LyonsAtlantic & Phillips Company

Contractor

COMPLETED

C E L N E N E

660 Ft. from N. Line

Ft. from S. Line

330 Ft. from E. Line

Ft. from W. Line

SECTION PLAT

			0

Location _____

Rig up _____

Drilling and Remarks:

P-133/4 x 93/4

Pot 557

RECORD

Cased 7 in., 412 ft.Sand A-6 412

Gas _____

Oil _____

Total Depth 416

PRODUCTION

1st 24 hrs. Nat. _____

1st 24 hrs. after shot _____

Gas _____ Cu. Ft.

Dry Hole _____

Abandoned _____

Date

AUG 10 1938 19

H. D. Hatfield Scout