


Section 28 Township 24 Range 13-W

Well No. #1 Tanner

Company Anschutz  
Merle Pool

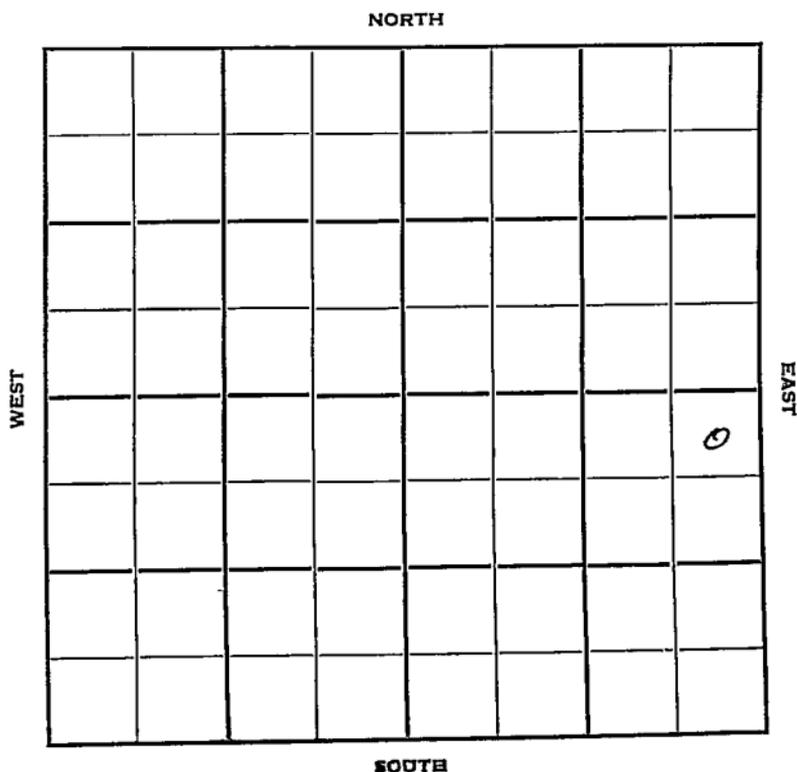

Sec. 28 Twp. 24 R. 13W

Well No. #1 Tanner Farm

Anschutz Company

Anschutz Contractor

**Merle Pool**


330' Ft. from N. Line

\_\_\_\_\_ Ft. from S. Line

330' Ft. from E. Line

\_\_\_\_\_ Ft. from W. Line

NE SE

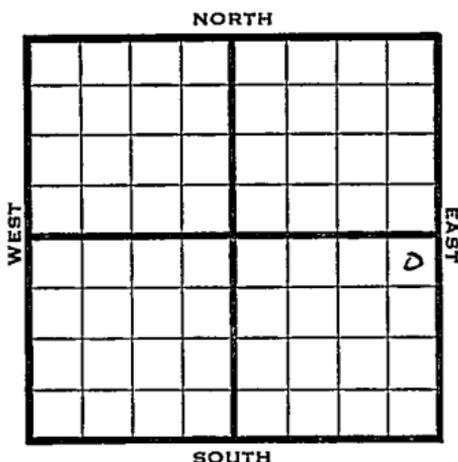

1949	Elev 1934'	REPORT
10/26	RUR	
11/1	8"@ 329'	
	Drlg 2633'	
11/9	Lansing 3569'	
	Viola 3942'	
	Drlg 4029'	
11/16	Arb. 4128-	
	5"@ 3880'	
	TD 4160'	
	FB 3810-24 shots 3779-87' W	
11/23	"	
11/29	"	
12/7	"	
12/14	"	
12/21	"	
12/28	"	
1950		
3/8	TD 4160'	
	8"@ 329'	
	5"@ 3880'	
	Lans 3569'	
	Arb. 4128'	
	25 BOPD	
	Comp	
	<b>COMPLETED</b>	

Map No. \_\_\_\_\_ Sec. 28 Twp. 24 R. 13W

Well No. I Tanner

\_\_\_\_\_  
Anschutz Company

\_\_\_\_\_  
Anschutz Contractor

NE SE

**FIRST REPORT**  
SECTION PLAT

330 Ft. from N. Line

\_\_\_\_\_ Ft. from S. Line

330 Ft. from E. Line

\_\_\_\_\_ Ft. from W. Line

			0

Stafford County

Location \_\_\_\_\_

Rig up \_\_\_\_\_

Drilling and Remarks:

R U R

**RECORD**

Cased \_\_\_\_\_ in., \_\_\_\_\_ ft.

Sand \_\_\_\_\_

Gas \_\_\_\_\_

Oil \_\_\_\_\_

Total Depth \_\_\_\_\_

**PRODUCTION**

1st 24 hrs. Nat. \_\_\_\_\_

1st 24 hrs. after shot \_\_\_\_\_

Gas \_\_\_\_\_ Cu. Ft.

Dry Hole \_\_\_\_\_

Abandoned \_\_\_\_\_

Date

OCT 26 1949

19

S. J. LEWIS

Scout

Map No. \_\_\_\_\_ Sec. 28 Twp. 24 R. 13WWell No. 1 TannerAnschutz Company

Contractor

NE SE

El. 1934  
SECTION PLAT330 Ft. from N. Line

\_\_\_\_\_ Ft. from S. Line

330 Ft. from E. Line

\_\_\_\_\_ Ft. from W. Line

			o

COMPLETE

Stafford County

Location \_\_\_\_\_

Rig up \_\_\_\_\_

Drilling and Remarks:

8" @ 3295" @ 3880Lans 3569arb 412825 BOPD

## RECORD

Cased \_\_\_\_\_ in., \_\_\_\_\_ ft.

Sand \_\_\_\_\_

Gas \_\_\_\_\_

Oil \_\_\_\_\_

Total Depth 4160

## PRODUCTION

1st 24 hrs. Nat. \_\_\_\_\_

1st 24 hrs. after shot \_\_\_\_\_

Gas \_\_\_\_\_ Cu. Ft.

Dry Hole \_\_\_\_\_

Abandoned \_\_\_\_\_

Date

J. E. TYRA

MAR 8 1950

Scout