


SECTION 28 TOWNSHIP 24S RANGE 13W

WELL NO. #3 Toland

COMPANY Artnell

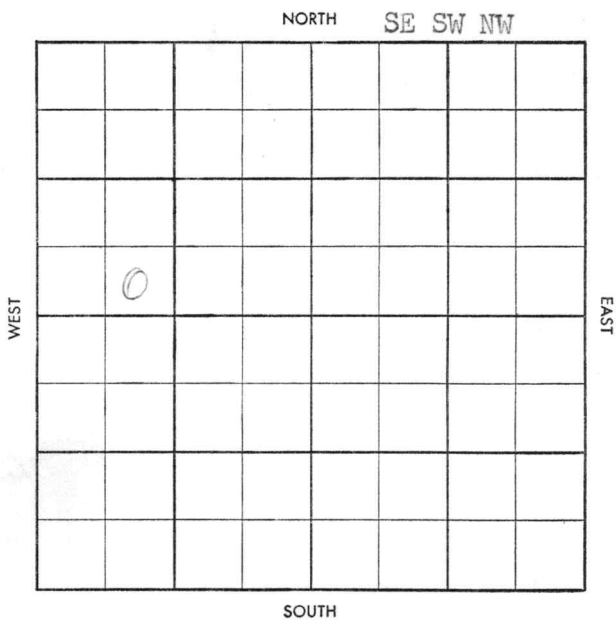

~~13~~

County Stafford Elev. _____
 Sec. 28 Twp. 24 Rge. 13W
 Company Artnell
 Farm Name Toland No. 3

TOPS	DEPTH	LOG	DATUM
Anh.			
Tp.			
H.			
Tr.			
Dg.			
B.L.			
L.			
K.C.			
B.K.C.			
Ce.			
C.			
M.			
M.			
K.			
Mz.			
Mq.			
V.			
S.			
S.			
A.			
R.			
Pf.			
G.			
T.D.			

Loc. in Sec. SE SW NW
 Geol. _____
 Contr. Leben Drlg.
 Pool Centerview



Date Comm. 2-24-58
8" @ 334/275 WOC

Co.

Lse.

No.

Sec.

T.

R.

Twp. X Pool

Co. Facet X

S-513-B

County Stafford Elev. 19320-19350

Sec. 28 Twp. 24 Rge. 13W

Company Artnell

Farm Name Toland No. 311

TOPS	DEPTH	LOG	DATUM
Anh.			
Tp.			
H.	<u>3422</u>	<u>3420</u>	
Tr.		<u>3440</u>	
Dg.			
B.L.	<u>3562</u>	<u>3560</u>	
L.	<u>3587</u>	<u>3594</u>	
K.C.			
B.K.C.	<u>3855</u>		
Ge.	<u>C Hart</u>	<u>3900</u>	
C.	<u>3912</u>		
M.			
M.			
K.		<u>3936</u>	
Mz.			
Mq.			
V.		<u>3978</u>	
S.	<u>24</u>	<u>4118</u>	
S.	<u>50</u>	<u>4135</u>	
A.	<u>4167</u>	<u>4166</u>	
R.			
Pf.			
G.			
T.D.	<u>4174</u>	<u>4173</u>	

Loc. in Sec. SE SW NW

Geol.

Contr.

Pool Centerview

COMPLETE

MAY 21 '58

Date Comm. 2-24-58

8" @ 334/275 WOG MAR 0 '58 @ 3600

MAR 12 '58 DST 3759-99 60" g/4"

30' g/cbs OCM + 60' HOB gem

150' VHO 29cm FP 85-110 BHP

1315/20" DST 3810-30 60"

720' gip 60' HOB gem FP 0-0

BHP 120 DST 4166-73 60" 120'

MCO 285' free oil FP 55-180

BHP 1340/20 120 5 1/2 4169/150

MAR 26 '58 APR 2 '58 APR 9 '58

Co.
Sec.
No.
Sec.
T.
R.

CO4174FU 600' OCM § 26BD
 NW 3hrs § 2½BFPH 30°W
 3hrs 300 A CP 900
 § 47BF 2hrs 30°W 2600'
 OB T & R w/pot + APR 16 '58 APR 23 '58
 APR 30 '58 MAY 7 '58 MAY 14 '58 MAY 21 '58

pot 121 130pd 349cw § 36°