


Stafford KANSAS

Section 28 Township 24 Range 13W

Well No. 1 Van Lieu

Company Natural Gas & Oil & Okla. Explor.

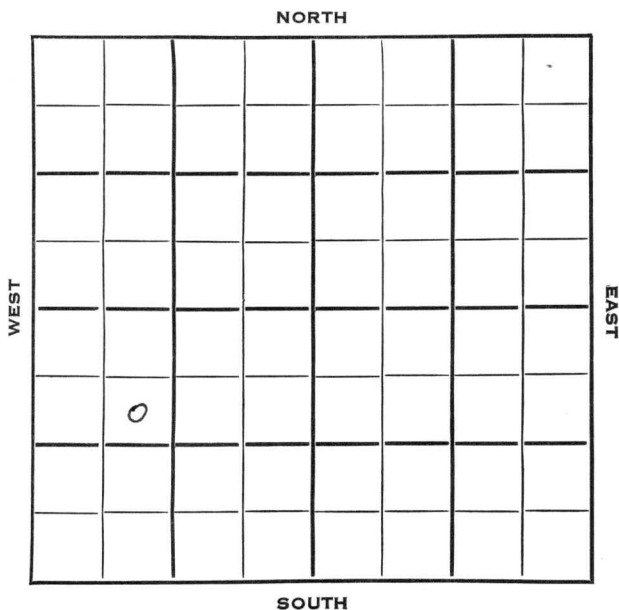


SEC.	28	TWP.	24	R.	13W ✓
------	----	------	----	----	-------

WELL NO. #1 Van Lieu FARM

COMPANY Natural Gas & Oil & Okla. Explor.

CONTRACTOR Co. Tools.

990 \_\_\_\_\_ Ft. from N. Line  
 \_\_\_\_\_ Ft. from S. Line  
 \_\_\_\_\_ Ft. from E. Line  
 990 \_\_\_\_\_ Ft. from W. Line

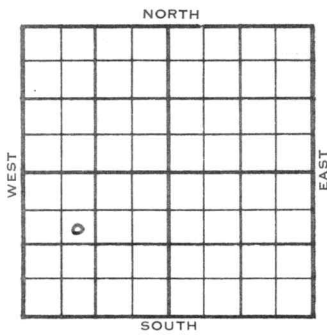

SE NW SW

	ELEVATION	REPORT
1953	1933'	
12/22	M I R	
1954		
1/6	8" @ 233'	Drlg 3866'
2/24	Spud 12-22-53	Oil Well
	TD 4193'	8" @ 233'
	Anhy 795', Heeb 3433', Br. Lime 3570'	lans 3597'
	DST 3757'-83' opn 3/4 hr, rec 30' Mud	195#
	DST 3793'-3830' opn 80 min, rec 34' Mud	100#
	DST 3832'-66' opn 1 hr, rec 20' Mud Off	B KC 3869', Cong 3924', Viola 4011'
	DST 4085'-4110' opn 1 hr, rec 40' Mud	Simp 4130', Arb 4177',
	DST 4178'-83' opn 1 hr, rec 10' oily	mud, 150' oil, 60' clean oil, 1320#
	DST 4184'-88' opn 1 hr, rec 435' smc	gassy oil, 200' sul. wtr. 1325#
	TD 4193'	5" @ 4192'
	CO to 4189'	

OVER

1954

Information brought forward.

2/24

perf 4185-88 S/ mud & Wtr. CO to 4195  
20/ 4188-93 S/ 3 bw & SSO CO to 4184  
20/ 4188-93 FU 22' sul. wtr. S/ 1 bw  
40 min. CO 4184'  
20/ 4180-84 1 qt oil 1000 mud-acid  
400 A S/ 27 boph 2 hr.  
P/ 13 boph 13% Wtr. P/ 30 bo 30% Wtr.  
Comp 116 bopd 10% Wtr.

COMPLETED





Drlg. Data

20/ 4188-93 S/ 3.bw & SSO CO to 4184

20/ 4188-93 FU 22' sul.wwtr. S/ 1 bw

40 min. CO 4184 20/ 4180-84 1 qt. oil

1000 mud acid 400' A S/ 27 boph 2 hr.

13 boph 13% wtr. P/ 30 bo 30% wtr.

Comp. 116 boph 10% wtr.

1986

Hand 2