


Stafford

Section **KANSAS** 29 Township 24 Range 11W

Well No. #1 Cooper "A"

Company Bridgeport

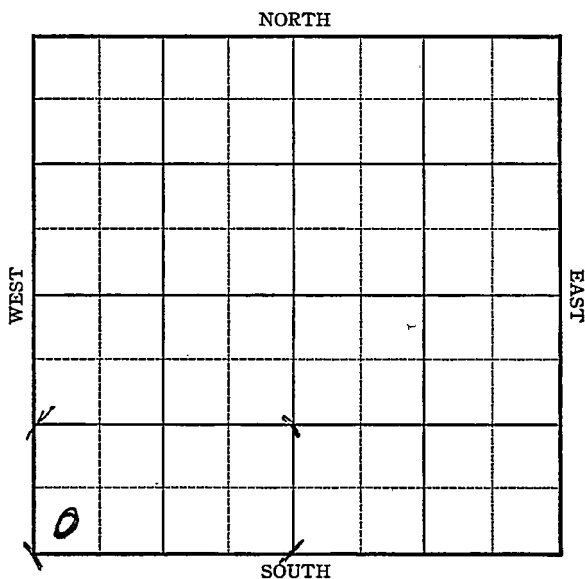

Stafford

KANSAS

Sec. 29 Twp. 24 R. 11W

Well No. #1 Cooper "A" Farm

Bridgeport Company


Wildcat

 Ft. from N. Line

330 Ft. from S. Line

 Ft. from E. Line

330 Ft. from W. Line

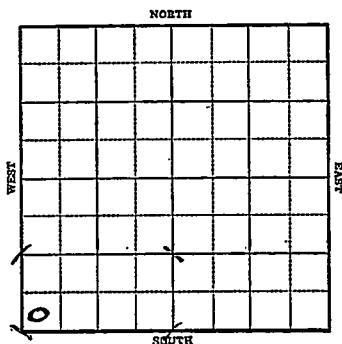

1944

R E P O R T

3/1 Rotary

3/8 8" @ 312
WOC.

3/16 Anhy. 595
Drlg. 2520

3/22 Lans 3468
TD 3681

3/29 Miss 3781
Kind 3806
Misener 3865
Viola 3897
Arb. 4078
TD 4102
No Shows

ABANDONED

KANSAS

Map No. 47 Sec. 29 Twp. 24 R. 11WWell No. 1 Cooper "A"Bridgeport


Company

FIRST REPORT

Contractor

SW/C

SECTION PLAT

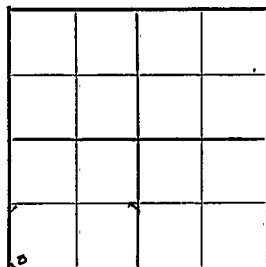

_____ Ft. from N. Line

330 Ft. from S. Line

_____ Ft. from E. Line

330 Ft. from W. Line

Wildcat

Location _____

Rig up _____

Drilling and Remarks:

Rotary

RECORD

Cased _____ in., _____ ft.

Sand _____

Gas _____

Oil _____

Total Depth _____

PRODUCTION

1st 24 hrs. Nat. _____

1st 24 hrs. after shot _____

Gas _____ Cu. Ft.

Dry Hole _____

Abandoned _____

Date

MAR 1 1944

19

S. I. LEWIS

Scout

KANSAS 7
 Map No. 67 Sec. 29 Twp. 24 R. 11W

Well No. 1 Cooper "A"

Bridgeport

Company

ABANDONED

Contractor

SW/C

SECTION PLAT

Ft. from N. Line

330

Ft. from S. Line

Ft. from E. Line

330

Ft. from W. Line

Wildcat

Location

Rig up

Drilling and Remarks:

Miss 3781





No shows

RECORD

Cased _____ in., _____ ft.

Sand _____

Gas _____

Oil _____

Total Depth 4102

PRODUCTION

1st 24 hrs. Nat. _____

1st 24 hrs. after shot _____

Gas _____ Cu. Ft.

Dry Hole _____

Abandoned _____

Date

MAR 29 1944

19

S. J. LEWIS

Scout