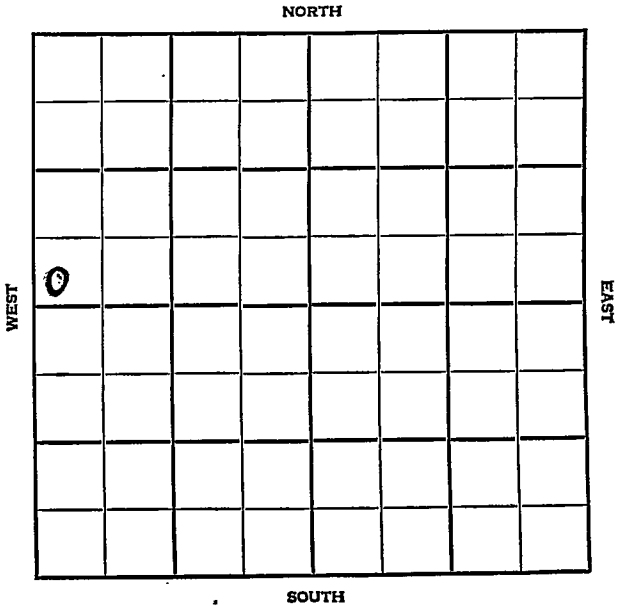


Section 29 Township 24 Range 11WWell No. 1 CooperCompany CRA & Rex & Morris

Stafford

KANSAS

SEC.	29	TWP.	24	R.	11W
------	----	------	----	----	-----

WELL NO.

1 Cooper

FARM

COMPANY

CRA & Rex & Morris

CONTRACTOR


Mo-Pac

Ft. from N. Line

Ft. from S. Line

Ft. from E. Line

Ft. from W. Line

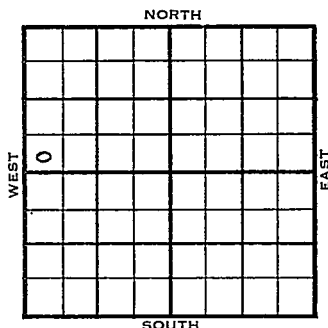

SW SW NW

1955

ELEVATION

1839

REPORT

6/29

Location

7/27

Comm 7-3-55

H 3284, Tr 3298, Dg 3326, B1 3439,

L 3466, V 3895

TD 3900

8 5/8" @ 321.200 5 1/2" @ 3897/75

GO to 3900 dry 100 M-A 7 gw 1 hr

DD 3905 FU 200' wtr DD 3915

D & A

ABANDONED

County Stafford Elev. _____ Co. _____
 Sec. 29 Twp. 24 Rge. 11W
 Company CRA & Rex & Morris
 Farm Name Cooper No. I

TOPS	DEPTH	LOG	DATUM	Loc. in Sec.
Anh.				SW ST NW
Tr.				
H.				
Tr.				
Dg.				
Bl.				
L.				Geol.
K.C.				Contr.
B.K.C.				
Ce.				
C.				
M.				Pool
M.				Mo-Pac
K.				
Mz.				
Mo.				
V.				
S.				
S.				
A.				
R.				
Pe.				
G.				
T.D.				

JUN 29 '55

0


FIRST REPORT

Date Comm. _____
 Location _____

12

County Stafford Elev. 1839
 Sec. 29 Twp. 24 Rge. 11W
 Company CR A & Rex & Morris
 Farm Name Cooper No. 1

TOPS	DEPTH	LOG	DATUM	Loc. in Sec.
Anh.				SW SW NW
Tr.				
H.	3284		1445	
Tr.	3294		1459	
Dg.	3310		1487	
BL.	3439		1600	
L.	3466		1627	
K.C.				Geol.
B.K.C.				Contr.
Ce.				
C.				
M.				
M.				Pool
K.				
Mz.				Mo-Pac
Mo.				
V.	3895		2056	
S.				
S.				
A.				
R.				
Pe.				
G.				
T.D.	2900			

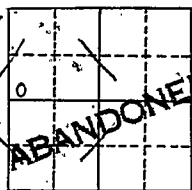

Date Comm. 7-3-55 JUL 27 1955

8 5/8" @ 321.200 5 1/2" @ 3897/75

CO to 3900 dry 100 M-A 7 gw 1 hr.

DD 3905 FU 200' wtr. DD 3915

D & A