
Stafford KANSAS

SECTION 29 TOWNSHIP 24S RANGE 12W

WELL NO. #1 Buckle

COMPANY Brunson Prod. & Exp.

NE NE SE

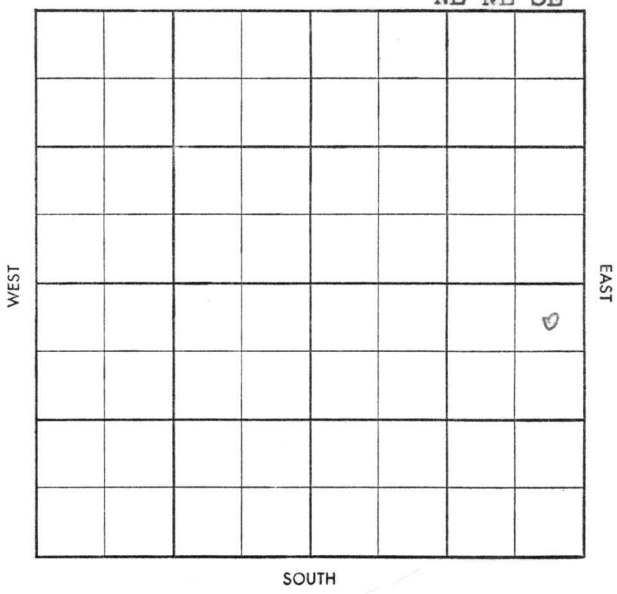

FORM 504-3 SUNRAY

Pool X

Pool X

Facet 13

WILDCAT

S-513-B

County Stafford Elev.

Sec. 29 Twp. 24 Rge. 12W

Company Brunson Prod. & Exp.

Farm Name Buckle No. 1

TOPS	DEPTH	LOG	DATUM
Anh.			
Tp.			
H.			
Tr.			
Dg.			
B. L.			
L.			
K.C.			
B.K.C.			
Ce.			
C.			
M.			
M.			
K.			
Mz.			
Mq.			
V.			
S.			
S.			
A.			
R.			
Pf.			
G.			
T.D.			

Loc. in Sec. NE NE SE

Geol.

Contr. Co. tools

Pool Wildcat



Date Comm. 7-9-58

SDX - ¼ mile

8" @ 281 drlg. 3345

Co. Lse. No. Sec. T. R.

Twp. X Pool X

Co. X Feet X

County Stafford Elev.

Sec. 29 Twp. 24 Rge. 12W

Company Brunson Prod. & Exp.

Farm Name Buckle No. 1

TOPS	DEPTH	LOG	DATUM
Anh.			
Tp.			
H.	3368	3370	
Tr.			
Dg.	3406	3407	
B. L.	3525	3523	
L.	3549	3548	
K.C.			
B.K.C.	3790	3790	
Ce.			
C.			
M.			
M. K.			
Mz.			
Mq.			
V.	3972	3972	
S. sd	4099	4094	
S.			
A. rowork Arb	4158	4158	
R.	4178	4167	
Pf.			
G.			
T.D.	4210		

Loc. in Sec. NE NW SE

Geol.

Contr. Co. tools

Pool Wildcat



Date Comm. 7-2-58

8" @ 281 drlg. 3345 JUL 23 58 DST

3586-3612 1hr 35' 50cm BHP

1262 - 211/20" FP 32-40

D&A

Co. Lse. No. Sec. T. R.