


SECTION 29 TOWNSHIP 24 RANGE 13W

WELL NO. #~~B~~ #1 Veeder

COMPANY Aurora Gasoline

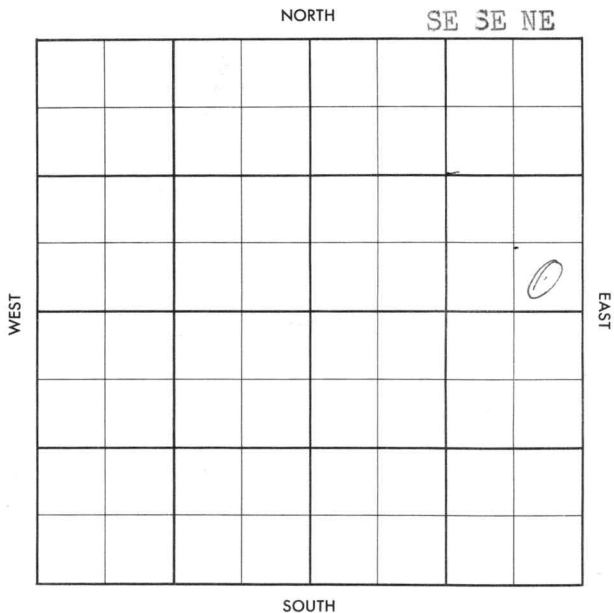

County Stafford Elev. 1936 RB
 Sec. 29 Twp. 24 Rge. 13W
 Company Aurora Gasoline
 Farm Name Veeder No. 3

TOPS	DEPTH	LOG	DATUM
Anh.	<u>824</u>		
Tp.			
H.			
Tr.			
Dg.			
Bl.			
L.			
K.C.			
B.K.C.			
Ce.			
C.			
M.			
M.			
K.			
Mz.			
Me.			
V.			
S.			
S.			
A			
R.			
Pe.			
G.			
T.D.			

Loc. in Sec. SE SE NE
 Geol. _____
 Contr. Chief Drlg.
 Pool _____
 Centerview

FIRST REPORT

MAY 22 57

Date Comm. 5-19-57
8" @ 412/350, Drlg. 2485

~~13~~

Co.
 Use.
 No.
 Sec.
 T.
 R.

1934 DF

County Starford Elev. 1936 RB
 Sec. 29 Twp. 24 Rge. 13W
 Company Aurora Gasoline
 FarmName Veeder No. 1

TOPS	DEPTH	LOG	DATUM	Loc. in Sec.
Anb.	824			SE SE NE
Tp.				
H.	3439			
Tr.	3459			
Dg.	3478			
Bl.	3578			
L.	3607			Geol.
K.C.				Contr.
B.K.C.	3877			Chief Drlg.
Ce.				Pool
C.	3922			Centerview
M.				
M.				
K.				
Mz.				
Me.				
V. <u>5/14</u>	4000			<div style="border: 1px solid black; padding: 5px; text-align: center;"> ABANDONED JUN 5 '57 </div>
S. <u>1/0/8</u>	4040			
S. <u>5P</u>	4128			
A.	4184			
R.				
PE.				
G.				
T.D.	4210			

Date Comm. 5-19-57

8" @ 412/350, Drlg. 2485 MAY 29 '57

DST 3765-90 30" rec. 10'

Md FP 0 BHP 0/20" DST

3800-19 1hr rec. 120' G.P.

rec 12' Md FP 0 BHP 00/20"

DST 3840-71 1hr rec. 37'

OCM FP 30-30 BHP 130/20

P 4086 JUN 5 '57

D & A