

Stafford

KANSAS

SECTION 29 TOWNSHIP 24 RANGE 13W

WELL NO. #1 Hoover

COMPANY Aurora Gasoline

NORTH SE NE SE

							0

WEST

EAST

SOUTH

SEC. 29	TWP. 24 S	R. 13 W
------------	--------------	------------

WELL NO. # 1 Hoover FARM

COMPANY Aurora Gasoline


CONTRACTOR Graybol Tools
Centerview

_____ FT. FROM N. LINE

_____ FT. FROM S. LINE

_____ FT. FROM E. LINE

_____ FT. FROM W. LINE

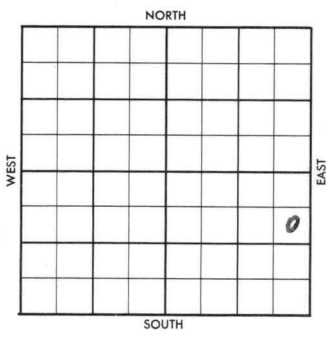

SE NE SE
SDX-1/4 Mile

1957	ELEVATION	REPORT
------	-----------	--------

3/27	Location	(FR Tkt)
------	----------	----------

County Stafford Elev. _____
 Sec. 29 Twp. 24 Rge. 13W
 Company Aurora Gasoline
 Farm Name Hoover No. 1

TOPS	DEPTH	LOG	DATUM
Anh.			
Tp.			
H.			
Tr.			
Dg.			
Bl.			
L.			
K.C.			
B.K.C.			
Ce.			
C.			
M.			
M.			
K.			
Mz.			
Me.			
V.			
S.			
S.			
A.			
R.			
PE.			
G.			
T.D.			

Loc. in Sec. SE NE SE
 Geol. _____
 Contr. _____
 Graybol Tools _____
 Pool _____
 Centerview _____

FIRST REPORT
 $\frac{1}{4}$ mile
 MAR 27 57

SDX-

Date Comm. _____
 Location _____

MAR 29 1957
 M M

Co.
 Lsg.
 No.
 Sec.
 T.
 R.

~~13~~

DST 3912-30 APR 17 '57 op. 65"
 rec 45' Md BHP 70/20
 DST 4017-82 op 45" rec 35'
 Md FP 0 BHP 0/20" DST
 4184-88 30" rec 15' Md
 BHP 520/20 5 1/2 @ 4188/100

APR 24 '57 W OCT MAY 1 '57 CO DP

4189 +st 2 1/2 Bwph +550
 PB 3880 24/3834-40 FU
 170' oil no/w 8 hrs T

\$ 12 B0 1hr FU 3200'
 oil \$ 39 B0 + 6% wtr
 1hr \$ 50 B0 + 6% wtr 2nd
 hr \$ 20 B0 + 6% wtr

35" T E R MAY 8 '57 / MAY 15 '57 MAY 22 '57
 Flwd 15 B0 12/64" ch.
 Flwd 58.52 B0 in 15 hrs TP

50# MAY 29 '57 JUN 5 '57 JUN 12 '57 JUN 19 '57 JUN 26 '57
 JUL 3 '57 JUL 10 '57 JUL 17 '57 JUL 24 '57 JUL 31 '57 AUG 8 '57

Ph P. 80 Bopd + 6% wtr.