


SECTION 29 TOWNSHIP 24 RANGE 13W

WELL NO. #1 Johnston

COMPANY Aurora Gasoline

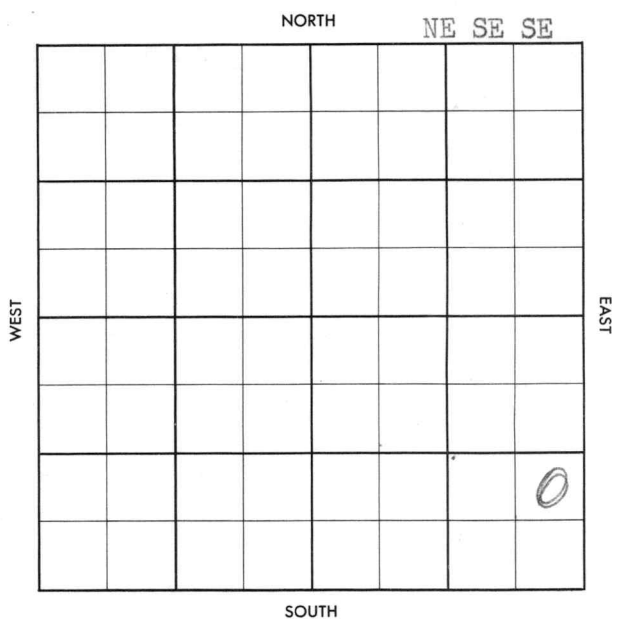

County Stafford Elev. _____
 Sec. 29 Twp. 24 Rge. 13W
 Company Aurora Gasoline
 Farm Name Johnston No. 1

TOPS	DEPTH	LOG	DATUM
Anh.			
T.p.			
H.			
Tr.			
Dg.			
Bl.			
L.			
K.C.			
B.K.C.			
Ce.			
C.			
M.			
M.			
K.			
Mz.			
Me.			
V.			
S.			
S.			
A			
R.			
Pe.			
G.			
T.D.			

Loc. in Sec. NE SE SE
 Geol. _____
 Contr. Chief Drlg.
 Pool _____

FIRST REPORT
 JUN 19 57

Date Comm. _____
 Location _____

13

Co.
 Lse.
 No.
 Sec.
 T.
 R.

Co.

Sec.

No.

Sec.

T.

R.

County Stafford Elev. 1936
 Sec. 29 Twp. 24 Rge. 13W
 Company Aurora Gasoline
 Farm Name Johnston No. 1

TOPS	DEPTH	LOG	DATUM	Loc. in Sec.
Anh.				NE SE SE
TP.				
H.	3436			
Tr.				
Dg.	3474			
Bl.	3523			
L.	3599			
K.C.				Geol.
B.K.C.	3873			Contr.
Ce.				Chief Drlg.
C.				
M.				Pool
M.				
K.				
Mz.				
Ma.				
V.				
S.				
S.				
A.				
R.				
PE.				
G.				
T.B.	3895			

COMPLETE		
AUG 7 '57		

Date Comm.
 Location JUN 25 '57 6-18-57 8¹/₈
403/350 ID 3065 JUL 3 '57 DST
3776-3815 1hr G/62" net 90'
H0E' GCM +150' 9554 oil +120'
M 9554 oil +15' 0CM BHP
115/20" DST 3828-55 1hr
180' gas net 65' 50E' GCM SW
BHP 1405/20" 5 1/2 3895/100
JUL 10 '57 24/3802-08 +5+1.67

Boph + 1090 wt $\frac{1}{2}$
 20 Boph + 390 wt 8hr

JUL 17 '57 POP > JUL 24 '57 JUL 31 '57 AUG 8 '57

Ph P. ~~66~~ 66 Boph + 1590
 wt.

29-24-13W

NE SE SE