


Section 29 Township 24 Range 11W
 Well No. 1 DeBusk
 Company Natural G&O

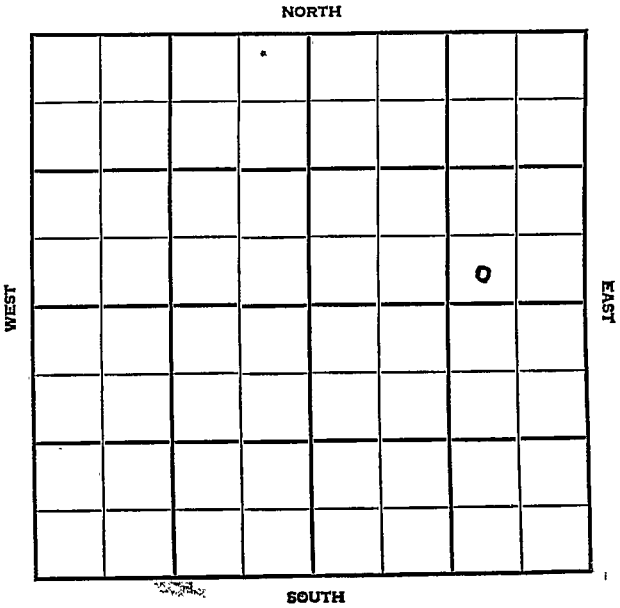

Stafford

KANSAS

SEC.	TWP.	R.
29	24	14W

WELL NO.

#1 DeBusk

FARM

COMPANY

Natural Gas & Oil

CONTRACTOR

Co. Tools.

Semi Wildcat.

_____ Ft. from N. Line


330

_____ Ft. from S. Line

990

_____ Ft. from E. Line

_____ Ft. from W. Line

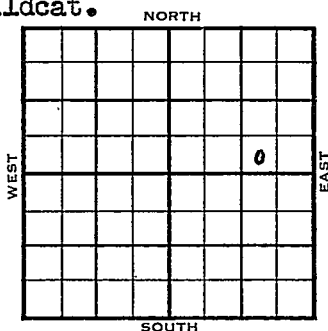

SW SE NE

	ELEVATION	REPORT
1954	1986'	

9/1 M I R
 9/22 D & A
 TD 4365'
 10" @213'
 Anhy 930', Heeb 3352', Br. Lime 3694'
 Lans 3715'
 DST 3743'-56' opn 1 hr, rec 45' Mud,
 630#
 DST 3738'-62' opn 1 hr, rec 140' so &
 gcm, 1115# Miss 4095', Viola 4189'
 Simp 4275' Arb 4337'
 TD 4365'
 D & A

ABANDONED

County Stafford State Kansas

Sec. 29 (Blk. 24) (Sur. 14W) Map No. _____

Operator Natural Gas & Oil

Well No. 1 Farm DeBusk

Elev.	Location	SW	SE	NE
-------	----------	----	----	----

FIRST REPORT

330 Ft. From S Line NE

990 Ft. From E. Line Quarter

1st. Report SEP 1 1954

Completion

Remarks _____


Co. tools

Spudding Date _____

Drlg. Data Semi Wildcat

M I R

FABIAN GILSTRAP

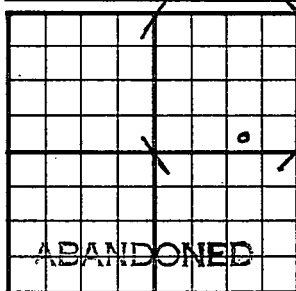County Stafford State KansasSec. 29 (Blk. Twp.) 24 (Sur. Rge.) 14W Map No.Operator Natural Gas & OilWell No. 1 Farm DeBuskElev. 1986 Location SW SE NE330 Ft. From S Line NE990 Ft. From E Line Quarter1st. Report Sep 1 1954Completion SEP 22 1954

Remarks

Co. Tools

Spudding Date

Drlg. Data D & A TD 4365 Semi Wildcat10" @ 213 Anhy 930 Heeb. 3352Br. lime 3694 Lans. 3715 DST 3743-56open 1 hr. Rec. 45' mud 630# DST 3738-62 open 1 hr. Rec. 140' so & gcm1115# Miss. 4095 Viola 4189Simp. 4275 Arb. 4337 TD 4365D & A

FABEN GILSTRAP