


Section 29 Township 24 Range 32 W

Well No. #~~2~~<sup>1</sup> Burnside 'H'

Company Northern Pump

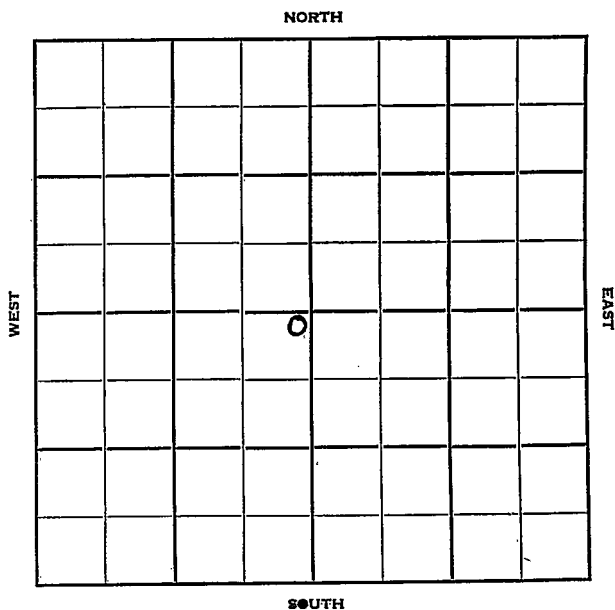

Finney

Sec. 29 Twp. 24 R. 32W

Well No. ~~#2~~ Burnside "A" Farm

Northern Pump Company

Contractor


Hugoton Pool

150' Ft. from N. Line

\_\_\_\_\_ Ft. from S. Line

150' Ft. from E. Line

\_\_\_\_\_ Ft. from W. Line

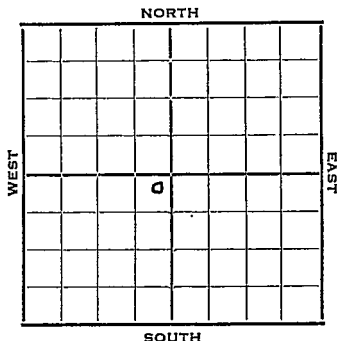

NE NE SW

1952 Elev. 2881' REPORT

2/20 Location  
 3/5 7" @ 2574 WOC  
 3/12 TD 2579'  
 3/19 "  
 3/25 TD 2579'  
 4/1 "  
 4/9 RUST DP DD to 2598 1000 A  
 2000 A Drlg. deeper  
 4/23 NR  
 4/30 DD 2676' TD 125' of 5" liner.  
 Winfield 2605' Towanda 2660'  
 5/7 NR  
 5/14 "  
 5/21 "  
 5/28 Spud 2-19-52 Gas Well  
 TD 2676' 10" @ 322' 7" @ 2558'  
 TD 2579' DD 2598 3000 A DD 2676  
 Win. 2605 Tow. 2660'  
 Comp. 5,750,000 gas

**COMPLETED**



*Finney*

Map No. \_\_\_\_\_ Sec. 29 Twp. 24 R. 32W

Well No. 1 Burnside "A"

Northern Pump. Company

Contractor

*NE NE SW*

150 Ft. from N. Line

\_\_\_\_\_ Ft. from S. Line

150 Ft. from E. Line

\_\_\_\_\_ Ft. from W. Line

SECTION PLAT

	<b>CORRECTION</b>		
	o		

Location \_\_\_\_\_

Rig up \_\_\_\_\_

Drilling and Remarks:

*Reported  
Northern Pump  
#2 Burnside*

RECORD

Cased \_\_\_\_\_ in., \_\_\_\_\_ ft.

Sand \_\_\_\_\_

Gas \_\_\_\_\_

Oil \_\_\_\_\_

Total Depth \_\_\_\_\_

PRODUCTION

1st 24 hrs. Nat. \_\_\_\_\_

1st 24 hrs. after shot \_\_\_\_\_

Gas \_\_\_\_\_ Cu. Ft.

Dry Hole \_\_\_\_\_

Abandoned \_\_\_\_\_

Date

3-9 1952

*J. J. M.*

Scout

