


Reno

Map No. KANSAS Sec. 3 Twp. 24 R. 4W
Well No. #2 Grandor Farm
McBride et al Company

NORTH

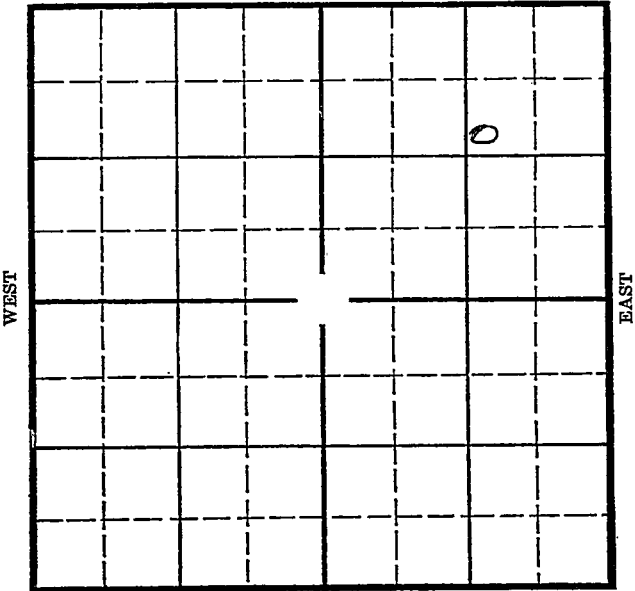

SOUTH

Location _____
Drilling Remarks _____

Rig Up _____
Drilling Remarks _____

RECORD

Cased _____ in. _____ ft.
Sand _____
Gas _____
Oil _____
Total Depth _____

PRODUCTION

1st 24 hrs. Nat. _____
1st 24 hrs. after shot _____
Gas _____ cu. ft. _____
Dry Hole _____
Abandoned _____

Map No. KANSAS Sec. 3 Twp. 24 R. 4W
Well No. 2-Grandon Farm
Mc Bride et al Company


990 Ft. from N. Line

_____ Ft. from S. Line

990 Ft. from E. Line

_____ Ft. from W. Line

Elev. 1468

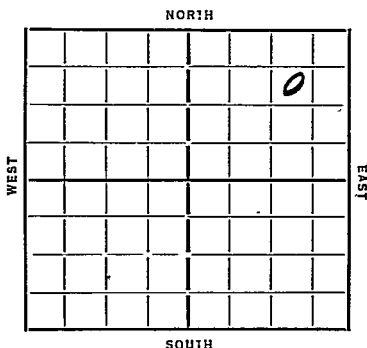

Date 1935 REPORT

7/24 Run S. P.
8/8 ddy 2213
8/15 " 3112
8/22 Chat 8260 8" 3326
ddy plug.
8/29 T 7 3361 4 3/8 Hds 12 hrs
1000 acid
9/4 Chat 3260
T 7 3361
1000 acid
146 Oil
20 Wts.

COMPLETED

Map No. 40 Sec. 3 Twp. 24 R. 4WWell No. 2 GrandonMc Bride & Co Company

Contractor

FIRST REPORTS

990 Ft. from N. Line

Ft. from S. Line

990 Ft. from E. Line

Ft. from W. Line

SECTION PLAT

			0

Location.....

Rig up.....

Drilling and Remarks:

*Run surface
Pipe*

RECORD

Cased.....in.,ft.

Sand.....

Gas.....

Oil.....

Total Depth.....

PRODUCTION

1st 24 hrs. Nat.....

1st 24 hrs. after shot.....

Gas.....Cu. Ft.

Dry Hole.....

Abandoned.....

Date

7/27/35 192

OVAL MARKS HERE

Scout

KANSAS

Map No. 40 Sec. 3 Twp. 24 R. 4WWell No. 2-BrandonMcBride et al Company

Contractor

TOWN

SECTION PLAT

			0

990 Ft. from N. Line

Ft. from S. Line

990 Ft. from E. Line

Ft. from W. Line

Location

Rig up

Drilling and Remarks:

1000 and146 oil
20 water

RECORD

Cased in ft.

Sand Chat 3260

Gas

Oil

Total Depth 3361

PRODUCTION

1st 24 hrs. Nat.

1st 24 hrs. after shot

Gas Cu. Ft.

Dry Hole

Abandoned

Date

9-4-35 192

ORVAL MANNSCHECK

Scout