


Map No. KANSAS Sec. 6 Twp. 24 R. 4WWell No. 4 Gypsy Oil Farm

Company

NORTH

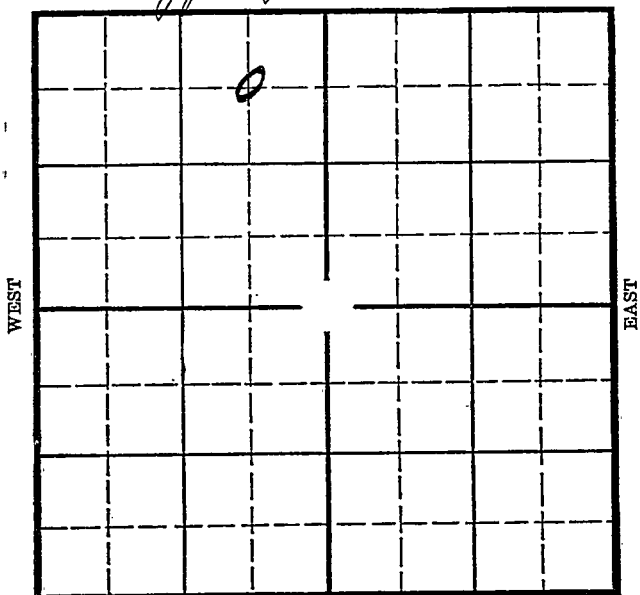

SOUTH

Location _____

Drilling Remarks _____

Rig Up _____

Drilling Remarks _____

RECORD

Cased _____ in. _____ ft.

Sand _____

Gas _____

Oil _____

Total Depth _____

PRODUCTION

1st 24 hrs. Nat. _____

1st 24 hrs. after shot _____

Gas _____ cu. ft. _____


Dry Hole _____

Abandoned _____

Reno

Map No. KANSAS Sec. 3 Twp. 24 R. 4W
Well No. 4 Myers Farm
Gypsy oil Company

NORTH

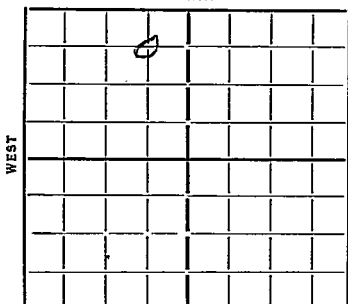

660 Ft. from N. Line

_____ Ft. from S. Line

660 Ft. from E. Line

_____ Ft. from W. Line

SOUTH

Date 7/35

REPORT

7/31 Rig
8/8 dly 800 15 1/2 250
8/15 " 2086
8/22 " 2975
8/29 TC 3274 TD 3325
8/14 3274
9/6 3345 TD 6 m. Gas.
10/3 dly 3360
10/10
10/30 Chat 3274
TD 3360
52 Oil
5 Wt

COMPLETED

Map No. 40 Sec. 3 Twp. 24 R. 4 ^W

Well No. 4 - Myers

Hydroy oil Company

Contractor

FIRST REPORTS

SECTION PLAT

660 Ft. from N. Line

 Ft. from S. Line

660 Ft. from E. Line

 Ft. from W. Line

	<u>0</u>		

Location

Rig up

Drilling and Remarks:

Rig Rot

RECORD

Cased in., ft.

Sand

Gas

Oil

Total Depth

PRODUCTION

1st 24 hrs. Nat.

1st 24 hrs. after shot

Gas Cu. Ft.

Dry Hole

Abandoned

Date

7-31-35 192

CEVAL MANNISCHRECK

Scout

KANSAS

Map No. 40 Sec. 3 Twp. 24 R. 4WWell No. 4-MyersPyro oil Company

Contractor

~~30. TLEED~~

SECTION PLAT

660 Ft. from N. Line

Ft. from S. Line

660 Ft. from E. Line

Ft. from W. Line

	0		

Location.....

Rig up.....

Drilling and Remarks:

52 oil
5 water

RECORD

Cased.....in.....ft.

Sand Chat 3274

Gas.....

Oil.....

Total Depth 3360

PRODUCTION

1st 24 hrs. Nat.....

1st 24 hrs. after shot.....

Gas.....Cu. Ft.

Dry Hole.....

Abandoned.....

Date

ORVAL MANNSCHRECK

10-30-35 192

Scout