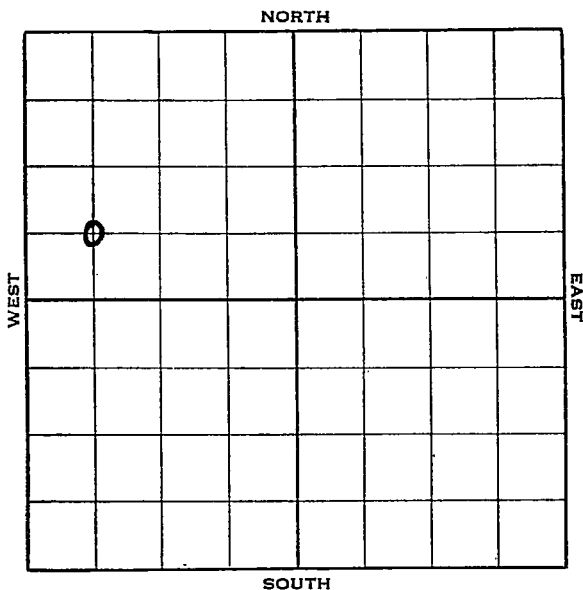



Section 3 Township 24 Range 4-WWell No. 8 MeyersCompany Gulf

KANSAS

Reno

Sec. 3 Twp. 24 R. 4-WWell No. #8 Meyers Farm
Gulf Company Ft. from N. Line660 Ft. from S. Line Ft. from E. Line660 Ft. from W. Line

Elev. 1472

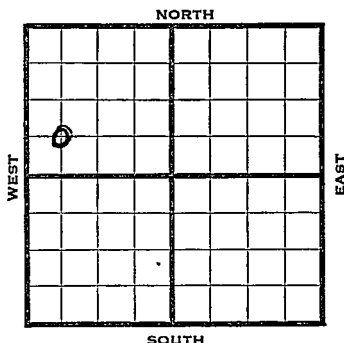

1938	REPORT
5/25	R.R.
6/3	16" @ 215'. Drlg. 790'.
6/10	Drlg. 2600'.
6/17	Chat 3273'. S.G. 3326-31'.
	S. O. 3345-49 & 3351-53'.
	8" at 3394'. T.D. 3395'. RUST.
6/24	Perforated 59 shots 3345-53'.
	2000' oil in 11 hrs. Will swab.
7/1	T.D. 3395' Swb. 86 oil & 53 wtr in
	8 hrs. P.B. 3367' 2000 acid
	Swab 136 oil & 45 water.
7/8	Testing.
7/15	Pump 277 oil & 124 wtr. in
	24 hrs. 3000 acid.
7/22	Testing.
7/29	3000 acid.
8/5	Testing.
8/12	"
8/19	"
8/26	"
	OVER

1938

9/2 T.D. 3395'.
Testing.

9/9 "

9/16 "

9/23 "

9/30 "

10/7 "

10/12 8" at 3394'.

Chat. 3273'.

T. D. 3395'.

Perf. pipe 3326-53.

P. B. 3367'.

8000 acid.

Potential 960 oil & 994 water.

COMPLETED

Reno

KANSAS

Map No. 40 Sec. 3 Twp. 24 R. 4WWell No. 8 MeyersGulf

Company

Contractor

FIRST REPORT

C SW NW

Ft. from N. Line

660 Ft. from S. Line

Ft. from E. Line

660 Ft. from W. Line

SECTION PLAT

o			

Location

Rig up

Drilling and Remarks:

RR

RECORD

Cased _____ in., _____ ft.

Sand _____

Gas _____

Oil _____

Total Depth _____

PRODUCTION

1st 24 hrs. Nat. _____

1st 24 hrs. after shot _____

Gas _____ Cu. Ft.

Dry Hole _____

Abandoned _____

Date

MAY 25 1938 19 H. D. Hatfield Scout

KANSAS

Reno

Map No. 40 Sec. 3 Twp. 24 R. 4WWell No. 8 Meyers

Gulf

Company

Contractor

COMPLETED

C SW NW

Ft. from N. Line

660 Ft. from S. Line

Ft. from E. Line

660 Ft. from W. Line

SECTION PLAT

0			

Location

Rig up

Drilling and Remarks:

Per F pipe 3326-50 ft

P.B. 3367

5000 acid

Pot 960 oil
994 WTR

RECORD

Cased 8 in., 3394 ft.Sand Chat 3273

Gas

Total Depth 3395

PRODUCTION

1st 24 hrs. Nat.

1st 24 hrs. after shot

Gas Cu. Ft.

Dry Hole

Abandoned

Date

OCT 12 1938 19 H. D. Hatfield Scout