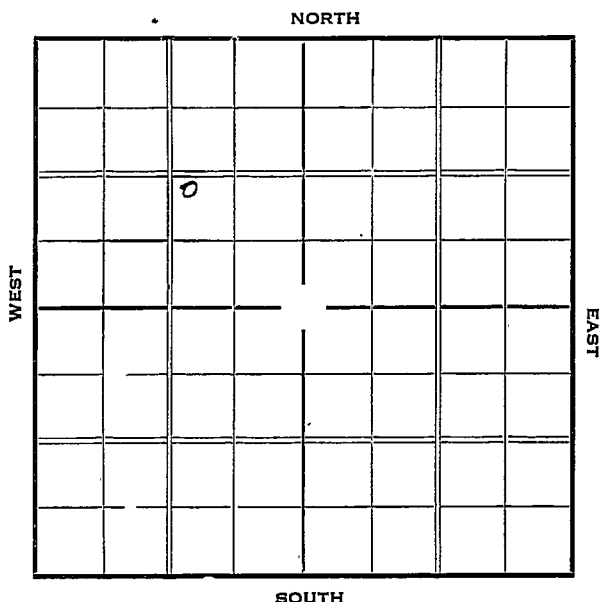


Reno

KANSAS

Section 3 Township 24 Range 4-WWell Number 2 J. MeyersCompany Gulf

KANSAS Reno

Map No. _____ Sec. 3 Twp. 24 R. 4-WWell No. #2 J. Meyers Farm _____


_____ Gulf. _____ Company

_____ Ft. from N. Line

990 Ft. from S. Line990 Ft. from E. Line

_____ Ft. from W. Line

Elev. 1471

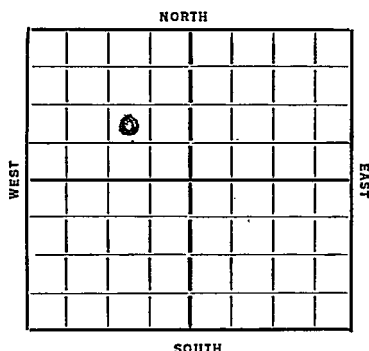

Date	REPORT
1936	
12/29	Rig. Will be a water disposal well.
1937	
1/7	15" @ 256'. WOG.
1/14	Drlg. 2150'.
1/21	Drlg. 3225'.
1/28	Misner 3597'. Hunton 3601'. Drlg. 3632'.
2/4	Viola 3703'. Simpson 3722'. Sil. 3815'. Drlg. 4115'.
2/11	Drlg. 4360'.
2/18	Drlg. 4744'.
2/26	Basil Sand 4520'. TD. 4772 will take 400 bbls water per hr by gravity
	OVER
	OVER
	OVER

1937

3/3 Basil Sand 4520'.

T. D. 4772'.

Water disposal.

Will take 400 bbls. per hour.

ABANDONED

Map No. _____ Sec. 3 Twp. 24 R. 4W.Well No. 2 J. Meyers.

Company _____

Contractor _____

SECTION PLAT

	0		

_____ Ft. from N. Line

990 Ft. from S. Line990 Ft. from E. Line

_____ Ft. from W. Line

FIRST REPORT

Location _____

Rig up _____

Drilling and Remarks:

Rig
will be a
water disposal
well

RECORD

Cased _____ in., _____ ft.

Sand _____

Gas _____

Oil _____

Total Depth _____

PRODUCTION

1st 24 hrs. Nat. _____

1st 24 hrs. after shot _____

Gas _____ Cu. Ft.

Dry Hole _____

Abandoned _____

Date

DEC 29 1936

19

S. J. LEWIS

Scout

KANSASMap No. 40 Sec. 3 Twp. 24 R. 4WWell No. 2 J. Meyer

Company

Contractor

SECTION PLAT

	6		

990 Ft. from N. Line990 Ft. from S. Line990 Ft. from E. Line

_____ Ft. from W. Line

~~ABANDONED~~~~ABANDONED~~**ABANDONED**

Location _____

RECORD

Cased _____ in., _____ ft.

Sand _____

Gas _____

Oil _____

Total Depth 4572**PRODUCTION**

1st 24 hrs. Nat. _____

1st 24 hrs. after shot _____

Gas _____ Cu. Ft.

Dry Hole _____

Abandoned _____

Rig up _____

Drilling and Remarks:

Basil Sand4520will take 40088 lb per hrWater Disposal

Date

MAR 3 1937 19

S. J. LEWIS

Scout