

*Keno*


Form 51-5M-5-34-Palace

Map No. **KANSAS** Sec. 3 Twp. 74 R. 4W

Well No. 3- Baughman Farm

Dickey & I T I O. Company

NORTH

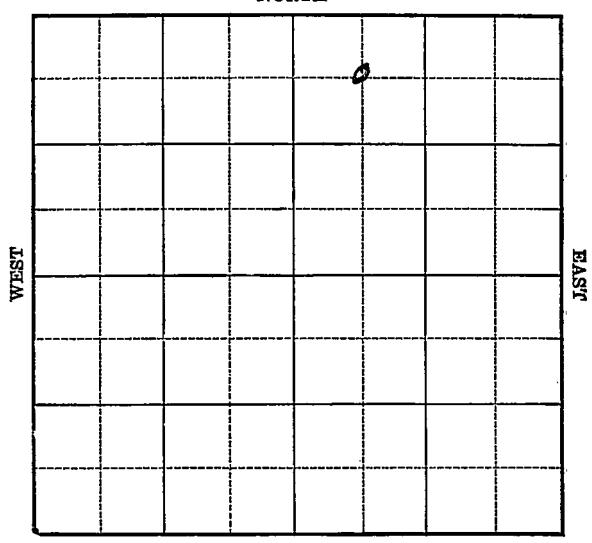

SOUTH

Location \_\_\_\_\_

Drilling Remarks \_\_\_\_\_

\_\_\_\_\_

\_\_\_\_\_

Rig Up \_\_\_\_\_

Drilling Remarks \_\_\_\_\_

\_\_\_\_\_

\_\_\_\_\_

**RECORD**

Cased \_\_\_\_\_ in. \_\_\_\_\_ ft.

Sand \_\_\_\_\_

Gas \_\_\_\_\_

Oil \_\_\_\_\_

Total Depth \_\_\_\_\_

**PRODUCTION**

1st 24 hrs. Nat. \_\_\_\_\_

1st 24 hrs. after shot \_\_\_\_\_

Gas \_\_\_\_\_ cu. ft.

Dry Hole \_\_\_\_\_

Abandoned \_\_\_\_\_

*Reno*

Map No. KANSA Sec. 3 Twp. 24 R. 4W

Well No. 3 - Baughman Farm


Rickey & I.T.I.O. Company

660 Ft. from N. Line

\_\_\_\_\_ Ft. from S. Line

\_\_\_\_\_ Ft. from E. Line

660 Ft. from W. Line

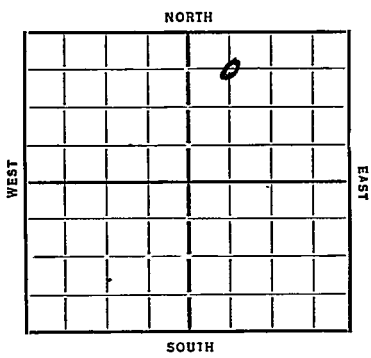

Date	REPORT
<i>7/35</i>	
<i>3/13</i>	<i>Location</i>
<i>3/21</i>	<i>— 3/28 — 4/4 —</i>
<i>4/11</i>	<i>Cellar</i>
<i>4/18</i>	<i>Rgn</i>
<i>4/26</i>	<i>15 1/2 182 10" 502 WOC</i>
<i>5/2</i>	<i>Dly 2200</i>
<i>5/9</i>	<i>" 3260 TC 3253</i>
<i>5/16</i>	<i>7" 3310</i>
<i>5/23</i>	<i>3365 177 Bbls 24 hrs 57M Gas</i>
	<i>1000 acid</i>
<i>5/29</i>	<i>—</i>
<i>6/5</i>	<i>Chat 3253 T 7 3365</i>
	<i>1000 acid 654 Bbls</i>

**COMPLETED**

Map No. 40 Sec. 3 Twp. 24 R. 4W

Well No. 3-Baughman

Pickey & ITIO Company

Contractor

**FIRST REPORTS**

**SECTION PLAT**

660 Ft. from N. Line

..... Ft. from S. Line

..... Ft. from E. Line

660 Ft. from W. Line

		0	

Location.....

Rig up.....

Drilling and Remarks:

**RECORD**

Cased..... in., ..... ft.

Sand.....

Gas.....

Oil.....

Total Depth.....

**PRODUCTION**

1st 24 hrs. Nat.....

1st 24 hrs. after shot.....

Gas..... Cu. Ft.

Dry Hole.....

Abandoned.....

Date

3-13-35 192

**ORVAL MANNSCHECK**

Scout

Map No. 40 Sec. 3 Twp. 24 R. 4 W

Well No. 3-Baughman

Rickey & ITIO Company

Contractor

SECTION PLAT

660 Ft. from N. Line

..... Ft. from S. Line

..... Ft. from E. Line

660 Ft. from W. Line

		0	

RECORD

Location.....

Rig up.....

Drilling and Remarks:

1000 and

654 bbls

Cased..... in., ..... ft.

Sand Chat 3253

Gas.....

Oil.....

Total Depth 3365

PRODUCTION

1st 24 hrs. Nat.....

1st 24 hrs. after shot.....

Gas..... Cu. Ft.

Dry Hole.....

Abandoned.....

Date

6-5-35 192.....

Scout