


Form 51-5M-4-36-Palace

Section 3 Township 24 Range 4-W

Well Number #2-Collins

Company Sinclair-Prairie

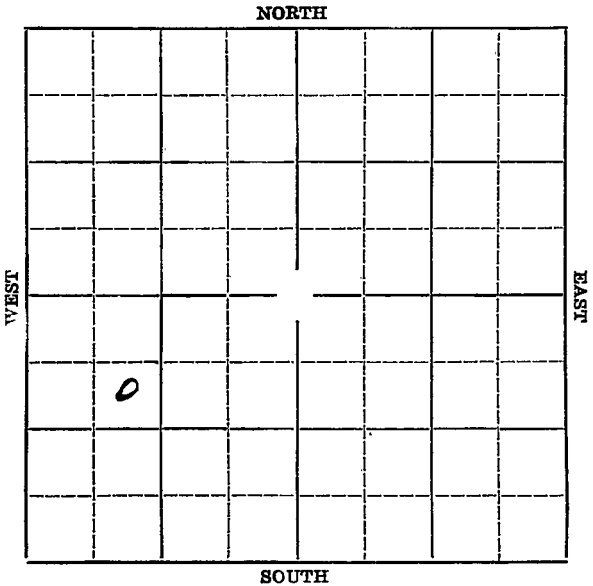

Map No. KANSAS Sec. 3 Twp. 24 R. 4W

Well No. #2 Collins Farm

Sinclair-Prairie Company


990' Ft. from N. Line

 Ft. from S. Line

 Ft. from E. Line

990' Ft. from W. Line

Elev. 1471

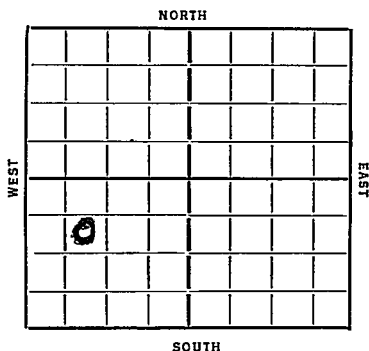

1936

REPORT

6/17 Location

6/25 ~~--- 7/2~~

7/2 Drlg. 1985'.

7/9 Drlg. 2995'.

7/16 Chat 3269'. Drlg. 3588'.

7/23 Hunton 3599'. 9" @ 3601'. Clean cut

7/30 TD 3606'. 1000 gallons of acid.
No test.

8/5/36-Hunton 3599'.

T.D. 3606'.

1000 gallons of acid.

Pot. 678 bbls of oil and 20 bbls
of water.

COMPLETED

Map No. KANSAS Sec. 3 Twp. 24 R. 4W

Well No. 2 Collins

Senclair-Prairie Company

Contractor

SECTION PLAT

990 Ft. from N. Line

_____ Ft. from S. Line

_____ Ft. from E. Line

990 Ft. from W. Line

FIRST REPORT

Location ✓

Rig up _____

Drilling and Remarks:

RECORD

Cased _____ in., _____ ft.

Sand _____

Gas _____

Oil _____

Total Depth _____

PRODUCTION

1st 24 hrs. Nat. _____

1st 24 hrs. after shot _____

Gas _____ Cu. Ft.

Dry Hole _____

Abandoned _____

Date

JUN 17 1936

S. J. LEWIS

Scout

KANSAS

Map No. 40 Sec. 3 Twp. 24 R. 4W

Well No. 2 Collins

Sinclair Prairie Company

Contractor

SECTION PLAT

0			

990 Ft. from N. Line

_____ Ft. from S. Line

_____ Ft. from E. Line

990 Ft. from W. Line

COMPLETED

Location _____

Rig up _____

Drilling and Remarks:

Hutton 3599

1000 acid

Port 678 oil

20 Water

RECORD

Cased _____ in., _____ ft.

Sand _____

Gas _____

Oil _____

Total Depth 3606

PRODUCTION

1st 24 hrs. Nat. _____

1st 24 hrs. after shot _____

Gas _____ Cu. Ft.

Dry Hole _____

Abandoned _____

Date

AUG 5 1936₁₉

S. J. LEWIS Scout