


Section 3 Township 24 Range 4-W

Well Number 4 M. Collins

Company Sinclair-Prairie

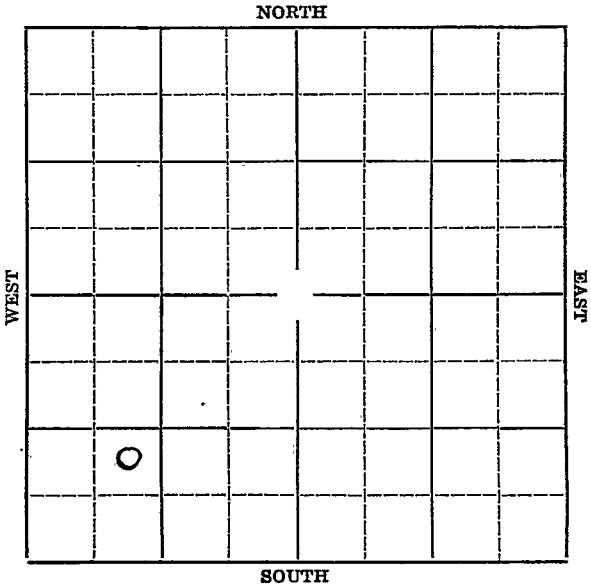

KANSAS *Reno.*

Map No. 40 Sec. 3 Twp. 24 R. 4W

Well No. 4 M Collins

Sinclair - Prairie Company

Contractor

SECTION PLAT

_____ Ft. from N. Line

990 Ft. from S. Line

_____ Ft. from E. Line

990 Ft. from W. Line

FIRST REPORT

Location _____

Rig up _____

Drilling and Remarks:

Rig

RECORD

Cased _____ in., _____ ft.

Sand _____

Gas _____

Oil _____

Total Depth _____

PRODUCTION

1st 24 hrs. Nat. _____

1st 24 hrs. after shot _____

Gas _____ Cu. Ft.

Dry Hole _____

Abandoned _____

Date

MAR 17 1937

19

S. J. LEWIS

Scout

KANSAS *Reno*

Map No. 40 Sec. 3 Twp. 24 R. 4 W

Well No. 4-Collins

Senclair Prairie Company

Contractor

COMPLETED

SECTION PLAT

0			

 Ft. from N. Line

990 Ft. from S. Line

 Ft. from E. Line

990 Ft. from W. Line

Location

Rig up

Drilling and Remarks:

2000 ACID

POT. 291

RECORD

Cased in., ft.

Sand Chat-3267

Gas

Oil

Total Depth 3359

PRODUCTION

1st 24 hrs. Nat.

1st 24 hrs. after shot

Gas Cu. Ft.

Dry Hole

Abandoned

Date **APR 28 1937**

19

H. D. Hatfield

Scout