

Map No. KANSAS Sec. 3 Twp. 24 R. 4 W *Reno*
 Well No. 5- Myers Farm
Hydco Oil Company

NORTH

WEST

EAST

SOUTH

Location _____

Drilling Remarks _____

Rig Up _____

Drilling Remarks _____

RECORD

Cased _____ in. _____ ft.

Sand _____

Gas _____

Oil _____

Total Depth _____

PRODUCTION

1st 24 hrs. Nat. _____

1st 24 hrs. after shot _____

Gas _____ cu. ft. _____

Dry Hole _____

Abandoned _____

Map No. KANSAS

Sec. 3

Twp. 24

Revo
4W

Well No. 5-Myers

Farm

Gypsy Oil

Company


 Ft. from N. Line

330 Ft. from S. Line

990 Ft. from E. Line

 Ft. from W. Line

Elev. 1470

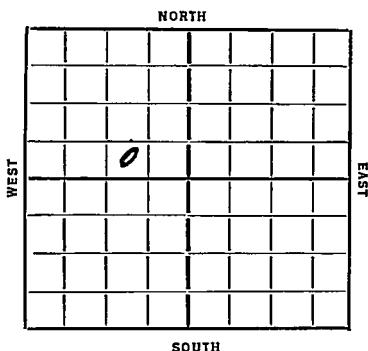

Date

REPORT

1935
12/4 Dig Cellar
12/13 B. Plot Rig
12/19 15" 319 TD 320 WOC
12/26 Dig 2322
1/2/36 " 3005
1/10 Top Chat 3263
the gas 3340-62
TD 3590
1/17 Top Hutton 3595 1/2
7" 3596 Cored 3595-98 TD
the Oil last 18" of core
Dig cement
1/24 TD 3602 flushed 17 Bbls
Oil per hr taking pot
1/29 Hutton 3595 1/2
TD 3602 1/2
1000 acid
1349 Bbls

COMPLETED

Map No. 4A Sec. 3 Twp. 24 R. 4 NWell No. 5-MyersEssey-oil Company

Contractor

FIRST REPORTS

SECTION PLAT

Ft. from N. Line

330 Ft. from S. Line990 Ft. from E. Line

Ft. from W. Line

Location

Rig up

Drilling and Remarks:

Rig clean

RECORD

Cased in., ft.

Sand

Gas

Oil

Total Depth

PRODUCTION

1st 24 hrs. Nat.

1st 24 hrs. after shot

Gas Cu. Ft.

Dry Hole

Abandoned

Date

12-4-35 192 MANNSCHRECK Scout

Map No. 40 Sec. 3 Twp. 24 R. 4WWell No. 5-MyersGypsy oil Company

Contractor

COMPLETE**SECTION PLAT**

	0		

Ft. from N. Line

330 Ft. from S. Line990 Ft. from E. Line

Ft. from W. Line

Location

Rig up

Drilling and Remarks:

1000 acid1349 fthls**RECORD**

Cased _____ in., _____ ft.

Sand Horton 3595 1/2

Gas _____

Oil _____

Total Depth 3602 1/2**PRODUCTION**

1st 24 hrs. Nat. _____

1st 24 hrs. after shot _____

Gas _____ Cu. Ft.

Dry Hole _____

Abandoned _____

Date

ORVAL MANNSCHRECK1-29-36 192

Scout