


6- Myers
Myers Oil
NORTH

NORTH

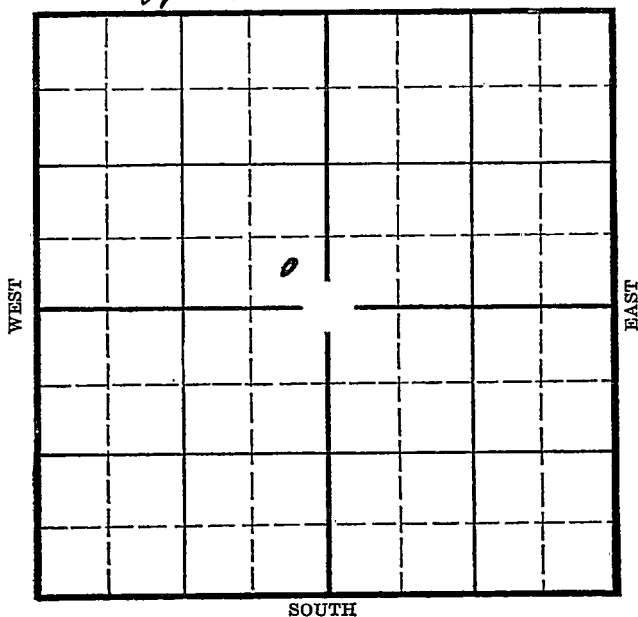

Rig Up _____
Drilling Remarks


PRODUCTION

1st 24 hrs. Nat. _____
1st 24 hrs. after shot _____
Gas _____ cu. ft. _____
Dry Hole _____
Abandoned _____

Map No. KANSAS Sec. 3 Twp. 24 R. 4W
Well No. 6- Myers Farm
Supply Oil Company


330 Ft. from N. Line

330 Ft. from S. Line

330 Ft. from E. Line

 Ft. from W. Line

Elev. 1470

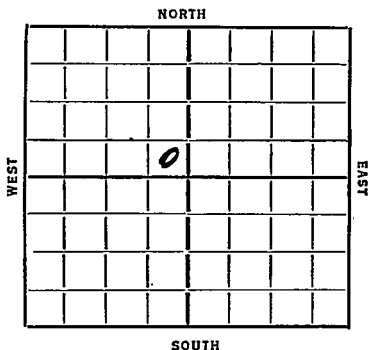

REPORT

1/29 Dig Cellar
2/7 Material
2/14
2/21 Dig 650 12" 267
2/28 " 2490
3/6 " 3056
3/13 T. Chat 3267 8" T.D. Rust.
3/25 Top Chat 3267
T.D. 3360
6 m Gas
435 Oil
71 Water

COMPLETED

KANSAS

Map No. 40 Sec. 3 Twp. 24 R. 4WWell No. 6-MyersHyessy oil Company

Contractor

FIRST REPORTS

Ft. from N. Line

330 Ft. from S. Line330 Ft. from E. Line

Ft. from W. Line

SECTION PLAT

	0		

Location

Rig up

Drilling and Remarks:

Rig cellar

RECORD

Cased _____ in., _____ ft.

Sand _____

Gas _____

Oil _____

Total Depth _____

PRODUCTION

1st 24 hrs. Nat. _____

1st 24 hrs. after shot _____

Gas _____ Cu. Ft.

Dry Hole _____

Abandoned _____

Date

1-29-36 192 ORVAL MANNSCHFECK Scout


Map No. 40 Sec. 3 Twp. 24 R. 4W

Well No. 6 Myers

Gypsy Oil Company

Contractor

SECTION PLAT

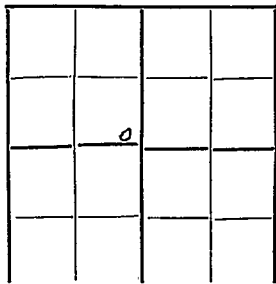

.....Ft. from N. Line

320 Ft. from S. Line

320 Ft. from E. Line

.....Ft. from W. Line

COMPLETE

Location.....

Rig up.....

Drilling and Remarks:

Top Qha 83267

6M Gas

435 Oil

71 Water

RECORD

Cased.....in.,ft.

Sand.....

Gas.....

Oil.....

Total Depth 3260

PRODUCTION

1st 24 hrs. Nat.....

1st 24 hrs. after shot.....

Gas.....Cu. Ft.

Dry Hole.....

Abandoned.....

Date

3/25/36 192

S. J. LEWIS

Scout