


Section 3 Township 24 Range 4-W

Well Number 3-Matlock

Company Sinclair-Prairie

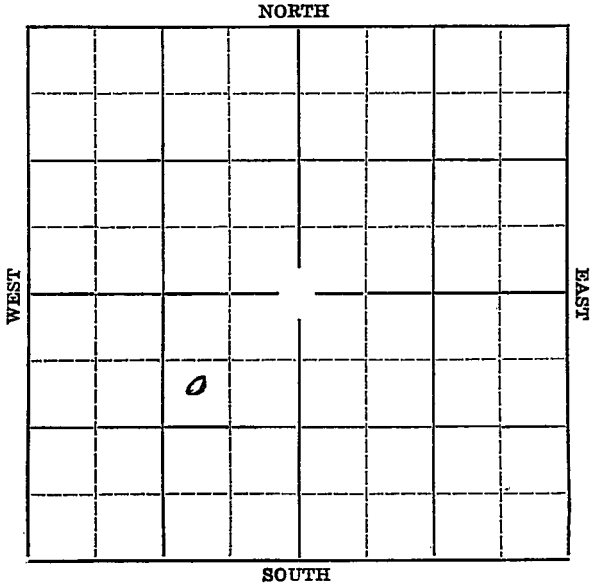

KANSAS

Map No. _____ Sec. 3 Twp. 24 R. 4W

Well No. #3 Matlock Farm _____

Sinclair-Prairie Company _____


990' Ft. from N. Line

_____ Ft. from S. Line

990' Ft. from E. Line

_____ Ft. from W. Line

Elev. 1471

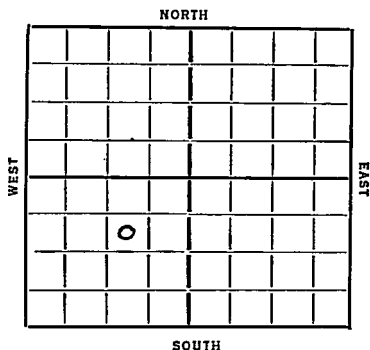

Date	REPORT
1936	
4/29	Rig.
5/7	15" @ 274' W.O.C.
5/14	Drlg. 2116'.
5/21	Drlg. 3249'.
5/28	Chat 3261'. Oil 3345'. Hunton 3590' to 95'. Run 8".
6/4	Coring 3597' to 3600'.
6/11	Swabb 10 bbls per hour. 1000 gals. acid. Pump 855 bbls in 10 hours.
6/24/36	Hunton 3591'. 1000 gallons acid. T.D. 3600'. 1046 bbls oil and 40 bbls water.
	COMPLETED

Send.
 Map No. 40 Sec. 3 Twp. 24 R. 4W

Well No. 3 Matlock

Sencclair-Prairie Company

Contractor

SECTION PLAT

990 Ft. from N. Line

..... Ft. from S. Line

990 Ft. from E. Line

..... Ft. from W. Line

	o		

FIRST REPORT

Location.....

Rig up.....

Drilling and Remarks:

Rig

RECORD

Cased..... in., ft.

Sand.....

Gas.....

Oil.....

Total Depth.....

PRODUCTION

1st 24 hrs. Nat.....

1st 24 hrs. after shot.....

Gas..... Cu. Ft.

Dry Hole.....

Abandoned.....

Date

APR 29 1936

S. J. LEWIS

192.....

Scout

KANSASMap No. 40 Sec. 3 Twp. 24 R. 4WWell No. 3 MatlockSinclair-Prairie Company

Contractor

SECTION PLAT

	0		

990 Ft. from N. Line

_____ Ft. from S. Line

990 Ft. from E. Line

_____ Ft. from W. Line

COMPLETED

Location _____

Rig up _____

Drilling and Remarks:

Hutton 35911000 acid1046 oil40 water**RECORD**

Cased _____ in., _____ ft.

Sand _____

Gas _____

Oil _____

Total Depth 3600**PRODUCTION**

1st 24 hrs. Nat. _____

1st 24 hrs. after shot _____

Gas _____ Cu. Ft.

Dry Hole _____

Abandoned _____

Date

JUN 24 1936 19S. J. LEWIS Scout