

KANSAS


Reno

Form 51-5M-4-36-Palace

Section 3 Township 24 Range 4-W

Well Number #4-Matlock

Company Sinclair-Prairie

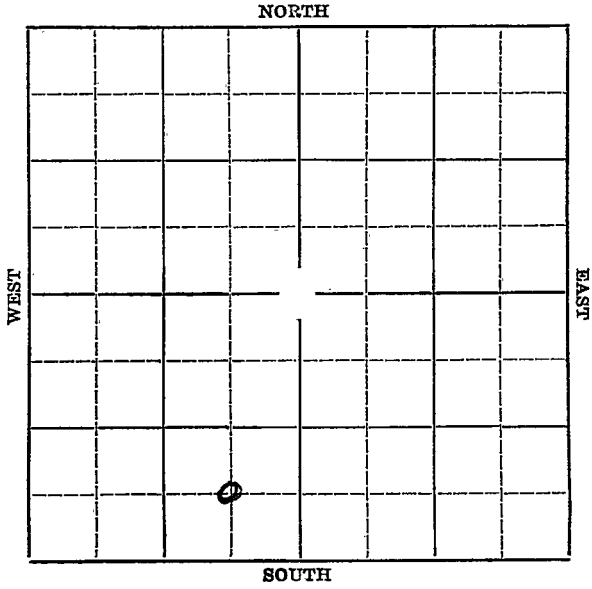

Map No. KANSAS Sec. 3 Twp. 24 R. 4W

Well No. #4 Matlock Farm


Sinclair-Prairie Company

_____ Ft. from N. Line

660' Ft. from S. Line

660' Ft. from E. Line

_____ Ft. from W. Line

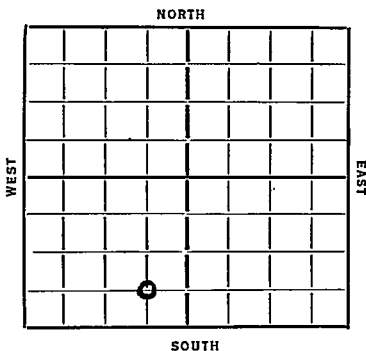

Elev. 1470

Date
1936

REPORT

8/5

Spud.

8/13

15" @ 357'. Drlg. 1000'.

8/20

Drlg. 2775'.

8/27

9" @ 3270'. Drlg. 3273'.

9/3

Gas 3288'-91'. Oil 3329'. Pay 3355'
to 58'. TD 3361'. Flow 875 bbls of
oil in 24 hours.

9/9/36

Miss Lime. 3261'.

T.D. 3361'.

Pay 3355-58'.

4000 gallons of acid.

Potential 1534 bbls of oil and
93 bbls of water.

COMPLETED

Map No. 40 Sec. 3 Twp. 24 R. 4WWell No. 4 Mat trackSinclair-Prairie Company

Contractor

SECTION PLAT

| | | | |
|--|--|--|--|
| | | | |
| | | | |
| | | | |
| | | | |
| | | | |

_____ Ft. from N. Line

660 Ft. from S. Line660 Ft. from E. Line

_____ Ft. from W. Line

FIRST REPORT

Location _____

Rig up _____

Drilling and Remarks:

Spud.

RECORD

Cased _____ in., _____ ft.

Sand _____

Gas _____

Oil _____

Total Depth _____

PRODUCTION

1st 24 hrs. Nat. _____

1st 24 hrs. after shot _____

Gas _____ Cu. Ft.

Dry Hole _____

Abandoned _____

Date

AUG 5 1936 19

S. J. LEWIS Scout

KANSAS

Map No. 40 Sec. 3 Twp. 24 R. 4W.

Well No. 4 Matlock

Sinclair-Prairie Company

Contractor

SECTION PLAT

| | | | |
|--|---|--|--|
| | | | |
| | | | |
| | | | |
| | 0 | | |

_____ Ft. from N. Line

660 Ft. from S. Line

660 Ft. from E. Line

_____ Ft. from W. Line

COMPLETED

Location _____

Rig up _____

Drilling and Remarks:

Miss L. 3261
Pay 3355-58
4000 acid
Pa 81534 oil
93 water.

RECORD

Cased _____ in., _____ ft.

Sand _____

Gas _____

Oil _____

Total Depth 3361

PRODUCTION

1st 24 hrs. Nat. _____

1st 24 hrs. after shot _____

Gas _____ Cu. Ft.

Dry Hole _____

Abandoned _____

Date

SEP 9 1936 ₁₉

S. J. LEWIS Scout