


Section 3 Township 24 Range 4-W

Well Number #5-Matlock

Company Sinclair-Prairie

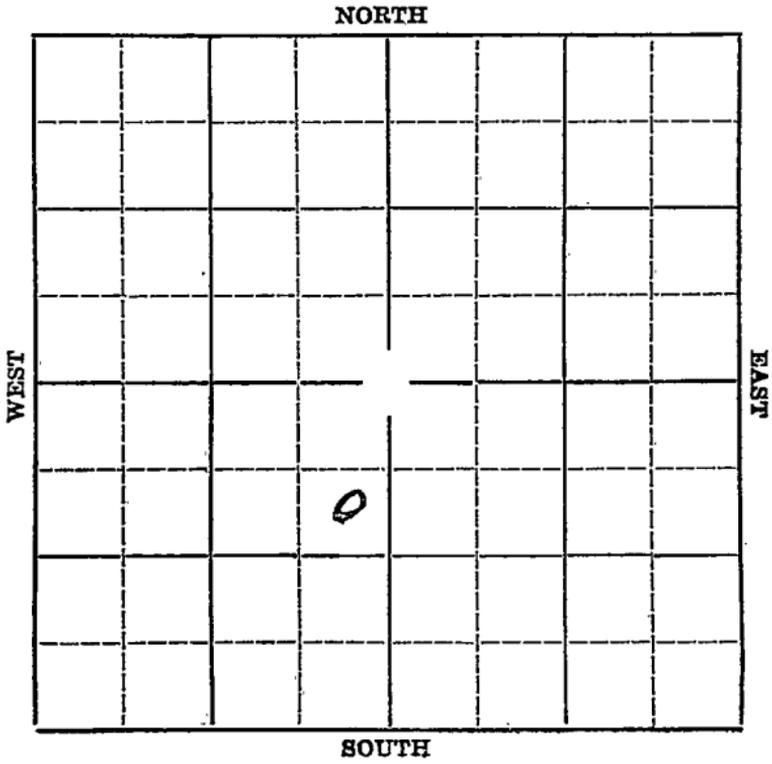

# KANSAS

Form 252-A—5M—7-36—Palace


Reno

Sec. 3 Twp. 24 R. 4W

Well No. #5 Matlock Farm

Sinclair-Prairie Company

990' Ft. from N. Line  
 \_\_\_\_\_ Ft. from S. Line  
330' Ft. from E. Line  
 \_\_\_\_\_ Ft. from W. Line

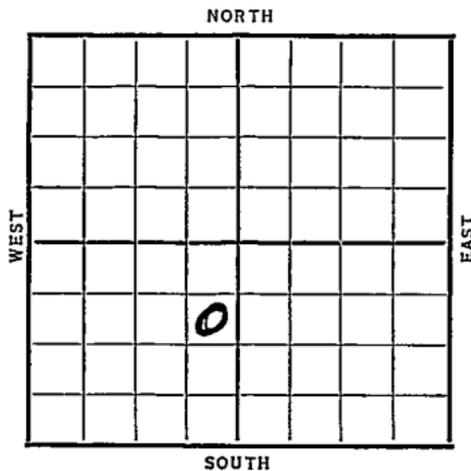

Elev. 1471

~~1936~~

## REPORT

9/9	Rigging up.
9/18	15 1/2" @ 374'. Drlg. 450'.
9/24	Drlg. 2035'.
10/1	Chat 3261'. 8 " @ 3267'. TD 3269'
	Waiting on cement.
10/8	T.D. 3360'. run tubing.
10/15	Flowed 608 bbls of oil. 110 water. 24 hours.
10/21/36	Chat 3261'.
	T.D. 3360'.
	2000 gallons of acid.
	Potential 641 oil and 113 water

**COMPLETED**

*Send.*

Map No. 40 Sec. 3 Twp. 24 R. 4W.

Well No. 5 Matlock

Sinclair-Prairie -Company

Contractor

SECTION PLAT

		0	

990 Ft. from N. Line

\_\_\_\_\_ Ft. from S. Line

930 Ft. from E. Line

\_\_\_\_\_ Ft. from W. Line

FIRST REPORT

Location \_\_\_\_\_

Rig up \_\_\_\_\_

Drilling and Remarks:

*Rigging up.*  
*WJ*

RECORD

Cased \_\_\_\_\_ in., \_\_\_\_\_ ft.

Sand \_\_\_\_\_

Gas \_\_\_\_\_

Oil \_\_\_\_\_

Total Depth \_\_\_\_\_

PRODUCTION

1st 24 hrs. Nat. \_\_\_\_\_

1st 24 hrs. after shot \_\_\_\_\_

Gas \_\_\_\_\_ Cu. Ft.

Dry Hole \_\_\_\_\_

Abandoned \_\_\_\_\_

Date

SEP 9 1936 19

S. J. LEWIS Scout

**KANSAS**

Map No. 40 Sec. 3 Twp. 24 R. 7W

Well No. 5 Matlock

Sinclair-Prairie Company

Contractor

**SECTION PLAT**


990 Ft. from N. Line

\_\_\_\_\_ Ft. from S. Line

330 Ft. from E. Line

\_\_\_\_\_ Ft. from W. Line

**COMPLETED**

Location \_\_\_\_\_

Rig up \_\_\_\_\_

Drilling and Remarks:

Chart 3261  
2000 acid  
Port 641 oil  
113 Water

**RECORD**

Cased \_\_\_\_\_ in., \_\_\_\_\_ ft.

Sand \_\_\_\_\_

Gas \_\_\_\_\_

Oil \_\_\_\_\_

Total Depth 3360

**PRODUCTION**

1st 24 hrs. Nat. \_\_\_\_\_

1st 24 hrs. after shot \_\_\_\_\_

Gas \_\_\_\_\_ Cu. Ft.

Dry Hole \_\_\_\_\_

Abandoned \_\_\_\_\_

Date

OCT 21 1936 19

S. I. LEWIS Scout