

FORM 51 5M 4-41 PETROL


Stafford

Section 3 Township 24 Range 11-W

Well No. #3 Henry

Company Deep Rock

NORTH Zenith pool

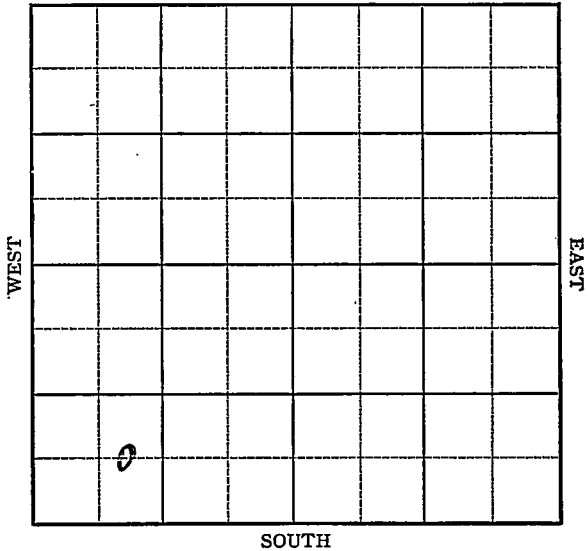

②

KANSAS


Stafford

Sec. 3 Twp. 24 R. 11-WWell No. #3 Henry FarmDeep Rock Company

(Zenith)

         Ft. from N. Line660 Ft. from S. Line         Ft. from E. Line990 Ft. from W. Line

Elev. 1817

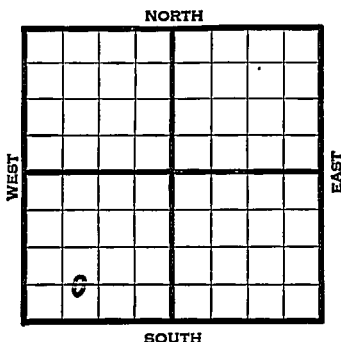

1941

## REPORT

10/15 Derrick.

10/23 10" - 549' WOC.

10/30 Drlg. 2425'

11/6 Viola 3749' T.D. 3751'

Run casing.

11/13 7" - 3750' RUST.

11/20 T.D. 3770' Flow 25 oil per hr -  
48 hours.

11/25 Viola 3749'

7" - 3750'

T.D. 3770'

5000 acid.

Bomb potential 1740 bbls.

42.6 Gravity

COMPLETED

Map No. 11-47 Sec. 3 Twp. 24 R. 11WWell No. 3 HenryDeen Rock Company

## FIRST REPORT

Contractor

C EL SW SW

## SECTION PLAT

|  |  |  |  |
|--|--|--|--|
|  |  |  |  |
|  |  |  |  |
|  |  |  |  |
|  |  |  |  |

         Ft. from N. Line660 Ft. from S. Line         Ft. from E. Line990 Ft. from W. Line

Zenith Pool

Location                                 Rig up                                 

Drilling and Remarks:

Derrick

## RECORD

Cased                  in.,                  ft.Sand                                 Gas                                 Oil                                 Total Depth                                 

## PRODUCTION

1st 24 hrs. Nat.                                 1st 24 hrs. after shot                                 Gas                                  Cu. Ft.Dry Hole                                 Abandoned                                 

Date

OCT 15 1917 19

S. J. LEWIS Scout

Map No. 15-47 Sec. 3 Twp. 24 R. 11WWell No. 3 HenryDeep Rock Company**COMPLETED** Contractor

C E L S W S W

         Ft. from N. Line660 Ft. from S. Line         Ft. from E. Line990 Ft. from W. Line

## SECTION PLAT

|  |  |  |  |
|--|--|--|--|
|  |  |  |  |
|  |  |  |  |
|  |  |  |  |
|  |  |  |  |

## ZENITH POOL

Location                                 Rig up                                 

Drilling and Remarks:

Viola 87497" @ 37505000 acidBore & P 28174042 5 gr

## RECORD

Cased          in.,          ft.Sand                                 Gas                                 Oil                                 Total Depth 3770

## PRODUCTION

1st 24 hrs. Nat.                                 1st 24 hrs. after shot                                 Gas                                  Cu. Ft.Dry Hole                                 Abandoned                                 

Date

NOV 25 1941 19 S. J. LEWIS Scout