KANSAS

Form 51—5M—7-40—Palace

Stafford

Section 3 Township 24 Range 11-W

Well No. #3 Johnson

Company Transwestern

Zenith Pool

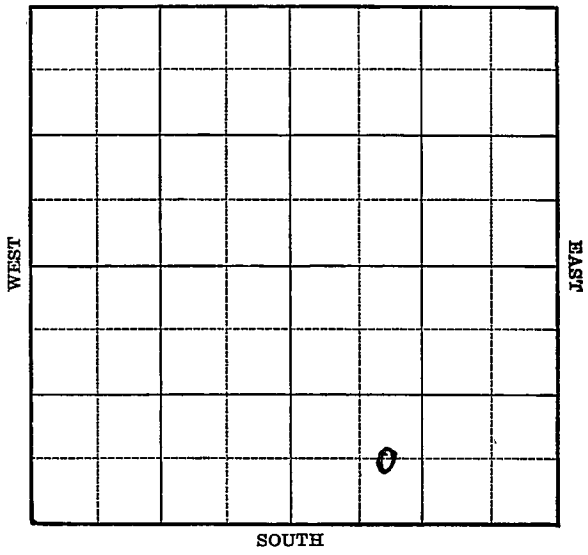

KANSAS Stafford

FORM 252-A 5M 2-40

Sec. 3 Twp. 24 R. 11-W

Well No. #3 Johnson Farm

Transwestern Company

(Zenith)

____ Ft. from N. Line

660 Ft. from S. Line

____ Ft. from E. Line

990 Ft. from W. Line

Elev. 1816

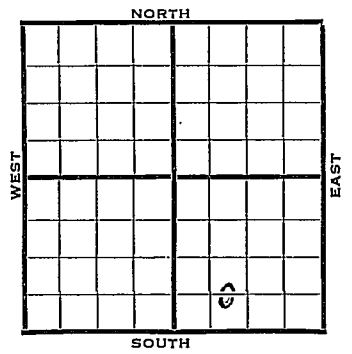

	REPORT
1940	
7/31	Moving in mat'l.
8/8	Derrick.
8/14	Sur. hole.
8/22	10" - 252' Drlg. 3196'
8/29	Viola 3711' T.D. 3775'
	7" - 3713' RUST.
9/5	Flow 406 bbls. 10 hours.
	Shut down.
9/11	Viola 3711'
	7" - 3713'
	T.D. 3775'
	5000 acid.
	Bomb potential 8632 bbls.
	Maximum 3000 bbls.
	COMPLETED

Form 26—200 Bks.—1-40—Palace

Stafford KANSAS

Map No. 47 Sec. 3 Twp. 24 R. 11W

Well No. 3 Johnson

Transwestern Company

Contractor

FIRST REPORT

C E½ SW SE

_____ Ft. from N. Line

660 Ft. from S. Line

_____ Ft. from E. Line

990 Ft. from W. Line

ZENITH POOL

SECTION PLAT

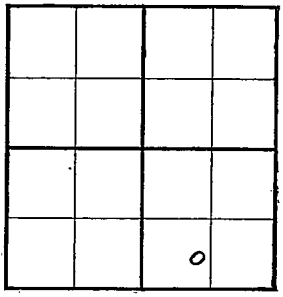

Location _____

Rig up _____

Drilling and Remarks:

Mov. in Matl.

RECORD

Cased _____ in., _____ ft.

Sand _____

Gas _____

Oil _____

Total Depth _____

PRODUCTION

1st 24 hrs. Nat. _____

1st 24 hrs. after shot _____

Gas _____ Cu. Ft.

Dry Hole _____

Abandoned _____

Date

JUL 31 1940 19

S. J. LEWIS Scout

Form 26—200 Bks.—1-40—Palace Stafford KANSAS

Map No. 47 Sec. 3 Twp. 24 R. 11W

Well No. 3 Johnson

Transwestern Company

Contractor

COMPLETED

C E½ SW SE

Ft. from N. Line

660 Ft. from S. Line

Ft. from E. Line

990 Ft. from W. Line

ZENITH POOL

SECTION PLAT

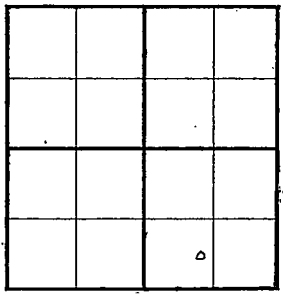

Location

Rig up

Drilling and Remarks:

Viola 3711

7" @ 3713

5000 acid

Bom. P. B. T.

3682

Max 3000

RECORD

Cased in., ft.

Sand

Gas

Oil

Total Depth 3775

PRODUCTION

1st 24 hrs. Nat.

1st 24 hrs. after shot

Gas Cu. Ft.

Dry Hole

Abandoned

Date

SEP 11 1940 19

S. J. LEWIS Scout