

# KANSAS

FORM 51 5M 10-41 PETROL


Stafford

Section 3 Township 24 Range 11-W

Well No. #1 Buckle

Company Great Lake Carbon

Zenith pool

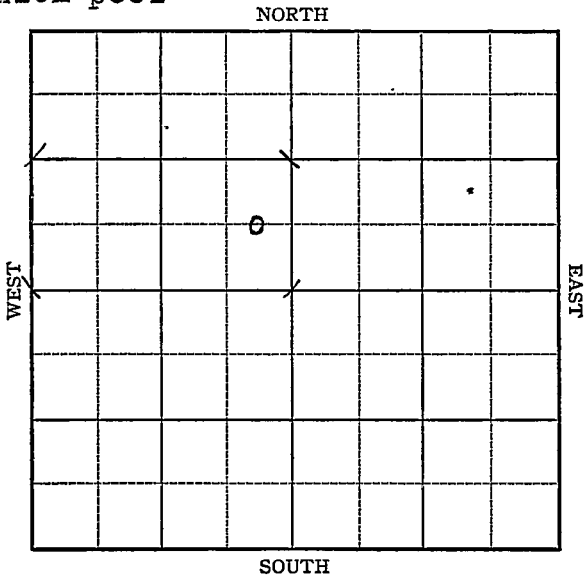

Sec. 3 Twp. 24 R. 11-W

Well No. #1 Buckle Farm

Great Lake Carbon Company


Zenith Pool

\_\_\_\_\_ Ft. from N. Line

660 Ft. from S. Line

330 Ft. from E. Line

\_\_\_\_\_ Ft. from W. Line

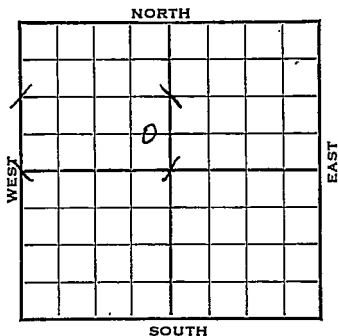

C EL SE NW Elev. 1813

1942

REPORT

12/2	Loc. Ohio Farmout
12/9	" <sub>2</sub> "
12/16	Drlg. 327
12/22	Drlg. 2209'
12/29	Drlg. 3141
1943 1/6	8" Casing set at 324 Lans 3364 Viola 3695 T. D. 3710' 5" Casing set at 3700 Rust.
1/13	TD 3730' Fill up 6bbls oil per hr.
1/20	3000 acid flow 40 oil per hr.
1/27	Flowed 151 bbls oil in 8 hrs Temp. Pot.
2/3	" " " "
2/10	" " " "
2/17	" " " "

**OVER**

1943

2/24

Viola 3695

5" @ 3700'

T.D. 3730'

3000 gal acid

Pump & flow 513 pot.

Gravity 42

**COMPLETED**

KANSAS

Map No. 47 Sec. 3 Twp. 24 R. 11WWell No. 1 Buckle

Great Lake Carbon Company

**FIRST REPORT** Contractor


C E L S E N W

SECTION PLAT

\_\_\_\_\_ Ft. from N. Line

660 Ft. from S. Line330 Ft. from E. Line

\_\_\_\_\_ Ft. from W. Line

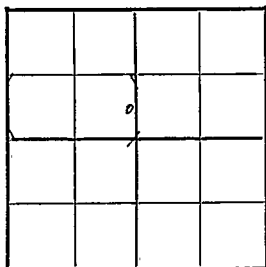

Z ENITH POOL

Location XXX

Rig up \_\_\_\_\_

Drilling and Remarks:

Ohio Farmout

## RECORD

Cased \_\_\_\_\_ in., \_\_\_\_\_ ft.

Sand \_\_\_\_\_

Gas \_\_\_\_\_

Oil \_\_\_\_\_

Total Depth \_\_\_\_\_

## PRODUCTION

1st 24 hrs. Nat. \_\_\_\_\_

1st 24 hrs. after shot \_\_\_\_\_

Gas \_\_\_\_\_ Cu. Ft.

Dry Hole \_\_\_\_\_

Abandoned \_\_\_\_\_

Date

DEC 2 1942 19S. J. LEWIS Scout

Stafford

Map No. ~~KANSAS~~ Sec. 3 Twp. 24 R. 11W

Well No. 1 Buckle

Great Lakes Carbon Company

COMPLETED

Contractor

C E L S E N W

SECTION PLAT

\_\_\_\_\_ Ft. from N. Line

660 Ft. from S. Line

330 Ft. from E. Line

\_\_\_\_\_ Ft. from W. Line


ZENITH POOL

Location \_\_\_\_\_

Rig up \_\_\_\_\_

Drilling and Remarks:

*Vida 3695-*  
*5" @ 2700*  
*2000 acid*  
*Pump & Flow*  
*513 P.Y.*  
  
*42° Gr*

RECORD

Cased \_\_\_\_\_ in., \_\_\_\_\_ ft.

Sand \_\_\_\_\_

Gas \_\_\_\_\_

Oil \_\_\_\_\_

Total Depth *3230*

PRODUCTION

1st 24 hrs. Nat. \_\_\_\_\_

1st 24 hrs. after shot \_\_\_\_\_

Gas \_\_\_\_\_ Cu. Ft.

Dry Hole \_\_\_\_\_

Abandoned \_\_\_\_\_

Date

FEB 24 1943

19

S. J. LEWIS Scout