

KANSAS


Stafford

FORM 51 5M 4-41 PETROL

Section 3 Township 24 Range 11-W

Well No. #4 Henry

Company Deep Rock

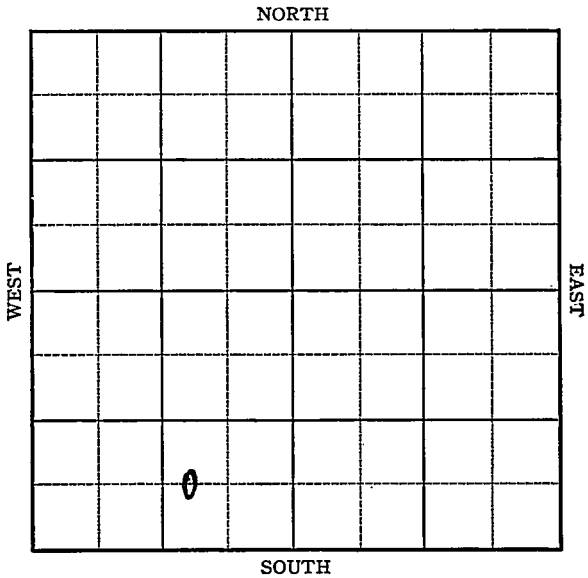

KANSAS


Stafford

Sec. 3 Twp. 24 R. 11-WWell No. #4 Henry FarmDeep Rock Company

(Zenith)

         Ft. from N. Line660 Ft. from S. Line990 Ft. from E. Line         Ft. from W. Line

Elev 1816

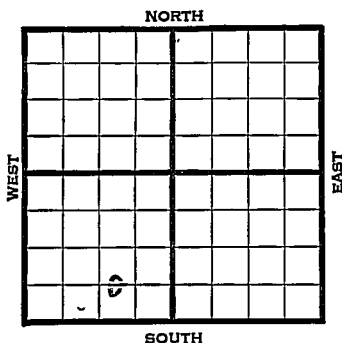

| 1941  | REPORT                        |   |   |   |   |
|-------|-------------------------------|---|---|---|---|
| 10/22 | Cellar.                       |   |   |   |   |
| 10/30 | "                             |   |   |   |   |
| 11/6  | Rotary.                       |   |   |   |   |
| 11/13 | 8" - 540' Drlg. 2105'         |   |   |   |   |
| 11/20 | Drlg. 4740'                   |   |   |   |   |
| 11/28 | Viola 3737 - 5" - 3738'       |   |   |   |   |
|       | Drlg. 3748'                   |   |   |   |   |
| 12/4  | T.D. 3771' 6000 acid.         |   |   |   |   |
|       | Flow 22 oil per hour 8 hours. |   |   |   |   |
| 12/11 | "                             | " | " | " | " |
| 12/18 | "                             | " | " | " | " |
| 12/24 | "                             | " | " | " | " |
| 12/31 | "                             | " | " | " | " |
| 1942  |                               |   |   |   |   |
| 1/8   | "                             | " | " |   |   |
| 1/15  | "                             | " | " |   |   |
| 1/22  | "                             | " | " |   |   |
| 1/29  | "                             | " | " |   |   |
| 2/5   | "                             | " | " |   |   |
| 2/12  | "                             | " | " |   |   |
| 2/19  | "                             | " | " |   |   |
| 2/26  | "                             | " | " |   |   |

OVER

1942

3/5 T.D. 3771'

3/12 "

3/19 "

3/25 Viola 3737'

4" - 3738'

T.D. 3771'

6000 acid.

Potential 476 bbls., flow.

4l. Gravity

**COMPLETED**

Stafford

KANSAS

Map No. K-47 Sec. 3 Twp. 24 R. 11WWell No. 4 HenryDeep Rock Company**FIRST REPORT** Contractor

C WL SE SW

## SECTION PLAT

         Ft. from N. Line660 Ft. from S. Line990 Ft. from E. Line         Ft. from W. Line

|  |   |  |  |
|--|---|--|--|
|  |   |  |  |
|  |   |  |  |
|  |   |  |  |
|  |   |  |  |
|  | o |  |  |

ZENITH P OOL

Location                                 Rig up                                 

Drilling and Remarks:

Cellar

## RECORD

Cased          in.,          ft.Sand                                 Gas                                 Oil                                 Total Depth                         

## PRODUCTION

1st 24 hrs. Nat.                         1st 24 hrs. after shot                         Gas                          Cu. Ft.Dry Hole                                 Abandoned                                 

Date

OCT 22 1941 19

S. J. LEWIS Scout

Map No. 47 Sec. 3 Twp. 24 R. 11WWell No. 4 HenryDeep Rock

Company

**COMPLETED**

Contractor

C WL SE SW

## SECTION PLAT

|  |   |  |  |
|--|---|--|--|
|  |   |  |  |
|  |   |  |  |
|  |   |  |  |
|  | 0 |  |  |

         Ft. from N. Line660 Ft. from S. Line990 Ft. from E. Line         Ft. from W. Line

## ZENITH POOL

Location                         Rig up                         

Drilling and Remarks:

*Viola 3237**4" @ 3735**6000 acid**Flow 476 Bx.**41° Gr*

## RECORD

Cased          in.,          ft.Sand                         Gas                         Oil                         Total Depth 3271

## PRODUCTION

1st 24 hrs. Nat.                         1st 24 hrs. after shot                         Gas                          Cu. Ft.Dry Hole                         Abandoned                         

Date

MAR 25 1942 19S. J. LEWIS

Scout