


Section 3 Township 24 Range 11-WWell No. #1 JohnsonCompany Transwestern

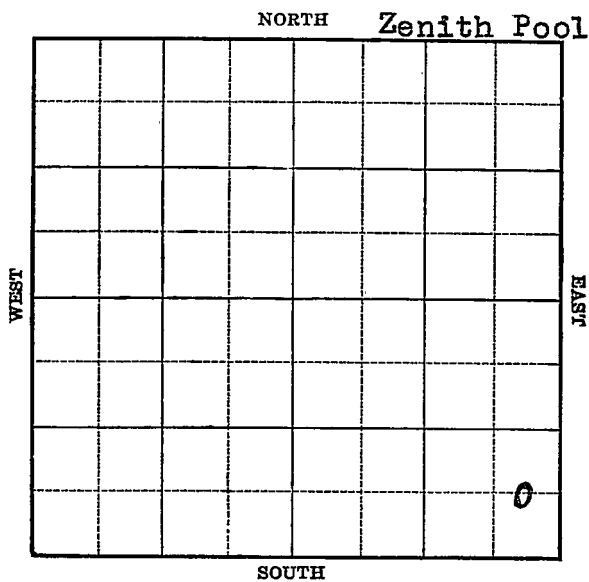

Stafford **KANSAS**Map No. 47 Sec. 3 Twp. 24 R. 11WWell No. 1 JohnsonTranswestern CompanyContractor**FIRST REPORT****C E L S E S E**         Ft. from N. Line660 Ft. from S. Line330 Ft. from E. Line         Ft. from W. Line**ZENITH POOL****SECTION PLAT**

|  |  |  |  |
|--|--|--|--|
|  |  |  |  |
|  |  |  |  |
|  |  |  |  |
|  |  |  |  |

Location         Rig up         

Drilling and Remarks:

**Derrick****RECORD**Cased          in.,          ft.Sand         Gas         Oil         Total Depth         **PRODUCTION**1st 24 hrs. Nat.         1st 24 hrs. after shot         Gas          Cu. Ft.Dry Hole         Abandoned         

Date

FEB 14 1940 19S. J. LEWIS Scout

Map No. 47 Sec. 3 Twp. 24 R. 11WWell No. 1 JohnsonTranswestern Company

Contractor

**COMPLETED**  
**C E L S E S E****SECTION PLAT**

|  |  |  |   |
|--|--|--|---|
|  |  |  |   |
|  |  |  |   |
|  |  |  |   |
|  |  |  | o |

         Ft. from N. Line660 Ft. from S. Line330 Ft. from E. Line         Ft. from W. Line**ZENITH POOL**Location                         Rig up                         

Drilling and Remarks:

*Muinel 8697**Vista 8710**9300 and 6**Born & Prod 1442***RECORD**Cased          in.,          ft.Sand                         Gas                         Oil                         Total Depth 3776**PRODUCTION**1st 24 hrs. Nat.                         1st 24 hrs. after shot                         Gas                          Cu. Ft.Dry Hole                         Abandoned                         

Date

APR 3 1940S. I. LEWIS Scout