

KANSAS


Stafford

FORM 51 5M 10-41 PETROL

Section 3 Township 24 Range 11-W

Well No. #1 Johnson

Company Great Lakes Carbon

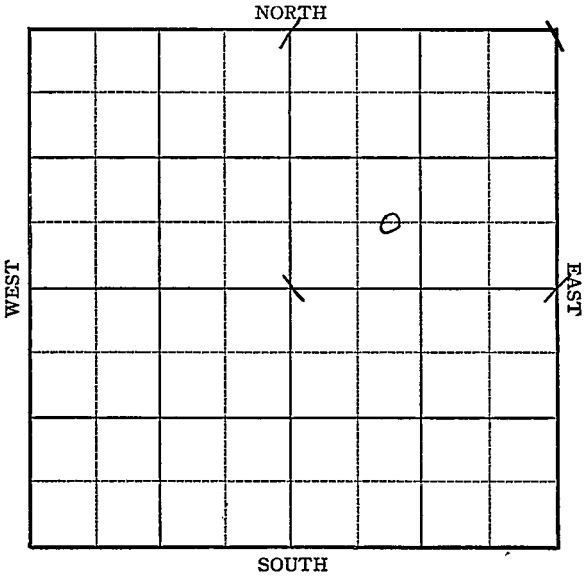

Sec. 3 Twp. 24 R. 11-W

Well No. #1 Johnson Farm

Great Lakes Carbon Company


Zenith

_____ Ft. from N. Line

660 Ft. from S. Line

_____ Ft. from E. Line

990 Ft. from W. Line

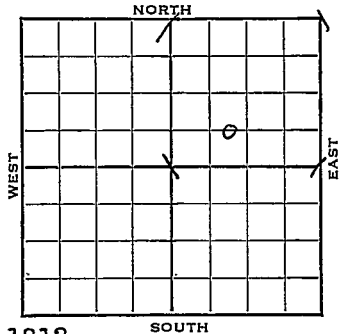

Elev. 1812

C E L SW NE

1943

REPORT

1/13

Location.

1/20

8" Casing set 244
Drlg. 1900'

1/27

Drlg. 3067'

2/3

Lans 3330

BKC 3675

Viola 3691

T.D. 3696'

2/10

5" @ 3693' RUST

TD 3735 Swab 11bbls oil per hr.
for 8 hrs.

2/17

3000 acid flow 15 bbls oil per hr
hr 10 hrs.

2/24

" " "

3/3

" " "

3/10

" " "

3/17

Viola 3691

5" @ 3693'

T.D. 3725'

3000 gal acid

Pump 160 bbls oil plus 24% water Pot.

Gravity 42

COMPLETED

KANSASMap No. 7 Sec. 3 Twp. 24 R. 11WWell No. 1 JohnsonGreat Lakes Carbon Company**FIRST REPORT**

Contractor

C EL SW NE**SECTION PLAT**

_____ Ft. from N. Line

660 Ft. from S. Line

_____ Ft. from E. Line

990 Ft. from W. Line

ZENITH POOLLocation XXX

Rig up _____

Drilling and Remarks:

RECORD

Cased _____ in., _____ ft.

Sand _____

Gas _____

Oil _____

Total Depth _____

PRODUCTION

1st 24 hrs. Nat. _____

1st 24 hrs. after shot _____

Gas _____ Cu. Ft.

Dry Hole _____

Abandoned _____

Date

JAN 13 1943

19

S I LEWIS Scout

KANSAS

Stafford

Map No. 47 Sec. 3 Twp. 24 R. 11WWell No. 1 JohnsonGreat Lakes Carbon Company**COMPLETED**

Contractor

C E L S W N E

SECTION PLAT

 Ft. from N. Line660 Ft. from S. Line Ft. from E. Line990 Ft. from W. Line

		0	

ZENITH POOL

Location Rig up

Drilling and Remarks:

*Viola 3691**5' @ 3698**3000 Gall**Pump 160 bit**24 to Water Pk.**42 @ 36*

RECORD

Cased in., ft.Sand Gas Oil Total Depth 3725

PRODUCTION

1st 24 hrs. Nat. 1st 24 hrs. after shot Gas Cu. Ft.Dry Hole Abandoned

Date

MAR 17 1943 19

S. J. LEWIS Scout