

KANSAS

Form 51-5M-7-40-Palace


Stafford

Section 3 Township 24 Range 11-W

Well No. #4 Johnson

Company Transwestern

NORTH Zenith Pool

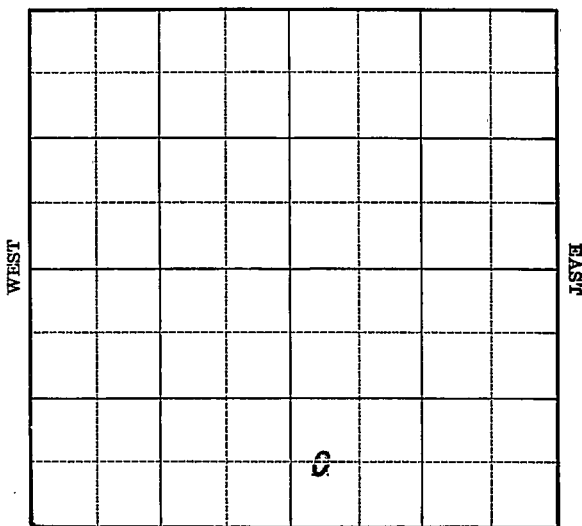

SOUTH

Map No. _____ Sec. 3 Twp. 24 R. 11W

Well No. 4 Johnson

Transwestern

Company

Contractor

FIRST REPORT

C W L SW SE

_____ Ft. from N. Line

660 Ft. from S. Line

_____ Ft. from E. Line

330 Ft. from W. Line

SECTION PLAT

| | | | |
|--|--|---|--|
| | | | |
| | | | |
| | | | |
| | | o | |

ZENITH POOL

Location X

Rig up _____

Drilling and Remarks:

RECORD

Cased _____ in., _____ ft.

Sand _____

Gas _____

Oil _____

Total Depth _____

PRODUCTION

1st 24 hrs. Nat. _____

1st 24 hrs. after shot _____

Gas _____ Cu. Ft.

Dry Hole _____

Abandoned _____

Date

AUG 21 1940

19

S. J. LEWIS

Scout

Map No. 47 Sec. 3 Twp. 24 R. 11WWell No. 4 JohnsonTranswesterm

Company

Contractor

COMPLETED

C W L SW SE

_____ Ft. from N. Line

660 Ft. from S. Line

_____ Ft. from E. Line

330 Ft. from W. Line

ZENITH POOL

SECTION PLAT

| | | | |
|--|--|---|--|
| | | | |
| | | | |
| | | | |
| | | o | |

Location _____

Rig up _____

Drilling and Remarks:

*Vista 3714**7" @ 3716.**Bomb PT 8273***RECORD**

Cased _____ in., _____ ft.

Sand _____

Gas _____

Oil _____

Total Depth 3771**PRODUCTION**

1st 24 hrs. Nat. _____

1st 24 hrs. after shot _____

Gas _____ Cu. Ft.

Dry Hole _____

Abandoned _____

Date

SEP 25 1940

19

S. J. LEWIS Scout