

KANSAS

Stafford

Section 3 Township 24 Range 12W

Well No. 1 Bartlett

Company Huber et al

Wildcat
NORTH

WEST

EAST

SOUTH

D.

KANSAS Stafford

Sec. 3 Twp. 24 R. 12W

Well No. #1 Bartlett Farm

Huber et al Company

Wildcat


330' Ft. from N. Line

 Ft. from S. Line

330' Ft. from E. Line

 Ft. from W. Line

NE SW

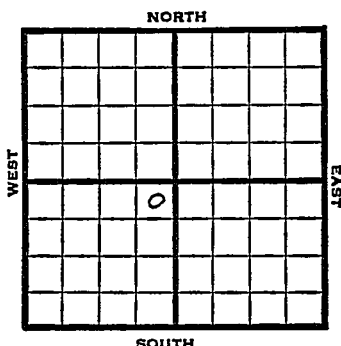

1948	Elev. 1865' REPORT
12/8	8" @ 170' Drlg. 1980'
12/14	Lansng 3445' Drlg. 3490'
12/22	Viola 3830' q Simpson 3948' Arbuckle 3998' TD 4048' 5" @ 3910'
12/29	"
1/5	"
1/12	"
1/19	"
1/26	Arb. 3998' TD 4048' ABANDONED

Map No. _____ Sec. 3 Twp. 24 R. 12WWell No. 1 Bartlett

Huber et al. _____ Company

FIRST REPORT

Contractor

NE SW


SECTION PLAT

330 Ft. from N. Line

_____ Ft. from S. Line

330 Ft. from E. Line

_____ Ft. from W. Line

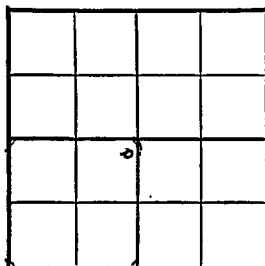

Stafford County

Location _____

Rig up _____

Drilling and Remarks:

8" @ 170

drlg. 1980

RECORD

Cased _____ in., _____ ft.

Sand _____

Gas _____

Oil _____

Total Depth _____

PRODUCTION

1st 24 hrs. Nat. _____

1st 24 hrs. after shot _____

Gas _____ Cu. Ft.

Dry Hole _____

Abandoned _____

Date

DEC 8 1943

19

S. J. LEWIS

Scout

Map No. 47 Sec. 3 Twp. 24 R. 12W

Well No. 1 Bartlett

Huber et al.

Company

ABANDONED

Contractor

NE SW

E 11865
SECTION PLAT


330 Ft. from N. Line

Ft. from S. Line

330 Ft. from E. Line

Ft. from W. Line

Stafford County

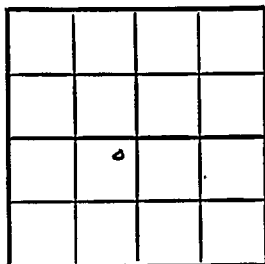

Location

Rig up

Drilling and Remarks:

Art 3998

RECORD

Cased _____ in., _____ ft.

Sand _____

Gas _____

Oil _____

Total Depth 4848

PRODUCTION

1st 24 hrs. Nat. _____

1st 24 hrs. after shot _____

Gas _____ Cu. Ft.

Dry Hole _____

Abandoned _____

Date

JAN 26 1949

19

S. J. LEWIS

Scout