

Stafford


KANSAS

FORM 51 25M 3-49 PETROL

Section 3 Township 24 Range 13W

Well No. #1 Delker Est.

Company Harper & Parrish

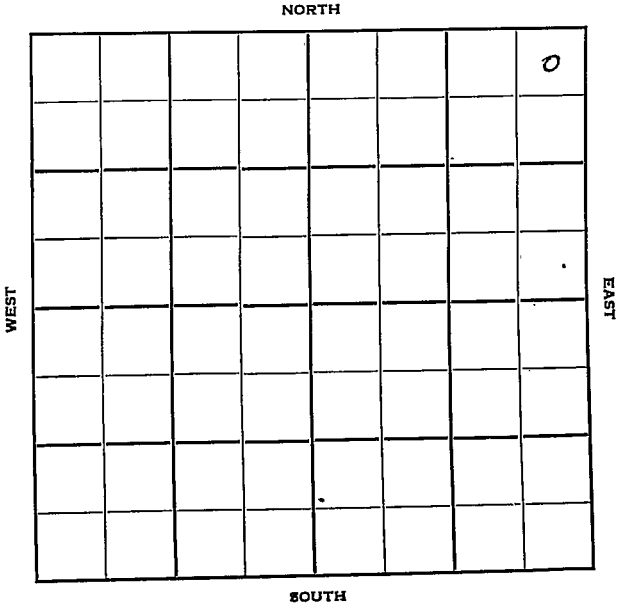

KANSAS Stafford

Sec. 3 Twp. 24 R. 13-W ✓

Well No. #1 Delker Est. Farm

Harper & Parrish Company

Contractor

Wildcat


330 Ft. from N. Line

Ft. from S. Line

330 Ft. from E. Line

Ft. from W. Line

NE NE NE

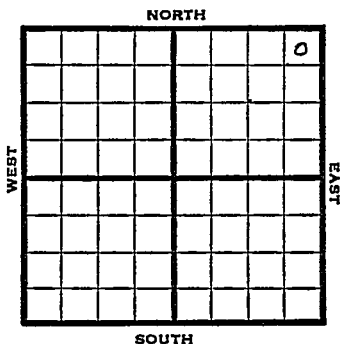

1950 Elev 1899' REPORT

3/22 Spud 3-17-50
8 5/8" @ 285'
Anhy 755-75
Drlg 1900'
4/5 TD 3983'
8 5/8" @ 285'
Heeb 3346'
Br L 3378'
Lans 3507'
Viola 3841'
Simp 3899'
Arb. 3963'
D&A
Aband.


ABANDONED

Map No. _____ Sec. 3 Twp. 24 R. 13WWell No. 1 Delker Est._____Harper & Parrish_____
Company_____
Contractor

NE NE NE

E1. 1899
SECTION PLAT330 Ft. from N. Line_____
Ft. from S. Line330 Ft. from E. Line_____
Ft. from W. Line

Stafford County

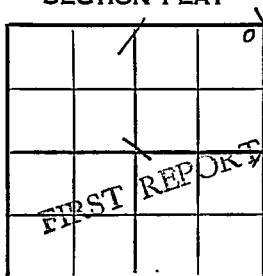

Location _____

Rig up _____

Drilling and Remarks:

Spud 3-17-50

8 5/8" @ 285

Anhy 755-75

drlg. 1900

RECORD

Cased _____ in., _____ ft.

Sand _____

Gas _____

Oil _____

Total Depth _____

PRODUCTION

1st 24 hrs. Nat. _____

1st 24 hrs. after shot _____

Gas _____ Cu. Ft.

Dry Hole _____

Abandoned _____

Date

MAR 22 1950 19 J. E. TYRA Scout

Kansas

Wildcat

Map No. _____ Sec. 3 Twp. 24 R. 13WWell No. 1 Delker Est.

Harper & Parrish

Company

Contractor


NE NE NE

E1. 1899
SECTION PLAT330 Ft. from N. Line

_____ Ft. from S. Line

330 Ft. from E. Line

_____ Ft. from W. Line

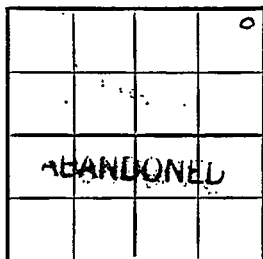

Stafford County

Location _____

Rig up _____

Drilling and Remarks:

8 5/8" @ 285Nub 3346Br L 3378dens 3507Viclu 3841Simp 3899ant 3963

RECORD

Cased _____ in., _____ ft.

Sand _____

Gas _____

Oil _____

Total Depth 3983

PRODUCTION

1st 24 hrs. Nat. _____

1st 24 hrs. after shot _____

Gas _____ Cu. Ft.

Dry Hole _____

Abandoned _____

Date

D + A

APR 5

1950

19

J. E. TYRA

Scout