

Stafford

Section 3 Township 24 Range 14W

Well No. 1 Anna Brown

Company Ben Brack

NORTH

WEST

EAST


SOUTH

11

Sec. 3 Twp. 24 R. 14W

Well No. #1 Anna Brown Farm

Ben Brack Company

Brack Contractor

wildcat


\_\_\_\_\_ Ft. from N. Line

330 Ft. from S. Line

330 Ft. from E. Line

\_\_\_\_\_ Ft. from W. Line

SE SE SE  
Carter acreage

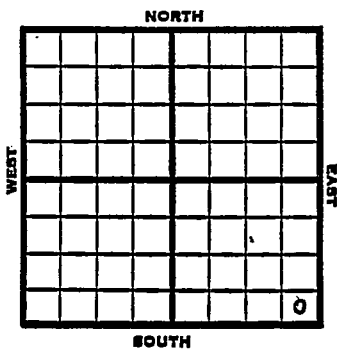

1952

**Elev. 1957' REPORT**

12/17 Set surface WOR

12/25 WOC

1/1 NR

1/8 8" @ 195 Anhy 870 Ø2641

1/23 Spud 1-2-52 D & A T 4240'  
 8" @ 195 -Anhy 870' Heeb 3479'  
 Br. line 3619' Lans. 3640'  
 DST 3756-70 open 1 hr. rec 45' VSOCM  
 63#  
 DST 3792-3800 open  $\frac{1}{4}$  hr rec 10' mud  
 230#  
 DST 3820-45 open 20 min rec 4' mud  
 Cong. 3969'  
 DST 3971-4005 open 20 min, rec 57'  
 GCM 934#  
 Viola 4047'  
 DST 4048-60 open 1 hr. rec 20' mud  
 Simp. 4162' Arb. 4202'  
 TD 4240' D & A

**ABANDONED**

4282 3640  
 1957 1957  
~~2775~~ -1683  
 4302

4282  
 1957  
 2775

County **Stafford** State **Kansas**

Sec. **3** (Blk. Twp.) **24** (Sur. Rge.) **14W** Map No.

Operator **Ben Brack**

Well No. **1** Farm **Anna Brown**

Elev. Location **SE SE SE**


**330** Ft. From **S** Line **SE**

**330** Ft. From **E** Line Quarter

Ist. Report **DEC 17 1952**

Completion

Remarks **Carter acreage**

**Brack - Contr.**

Spudding Date

Drlg. Data **Wildcat**

**set surface WOR**

