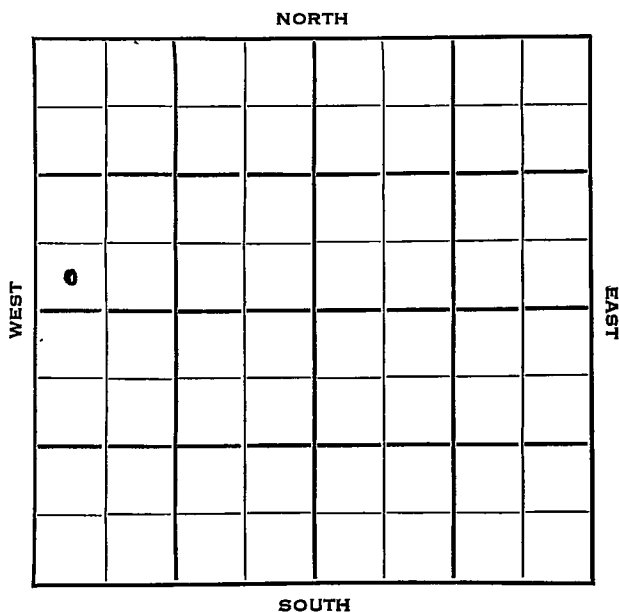


Section 3 Township 24 Range 14 WWell No. # 1 KoelschCompany Welch & Olsson Drlg.

Stafford

KANSAS

Sec. 3 Twp. 24 R. 14W

Well No. #1 Koelsch Farm

Welch & Olsson Drlg. Company

Welch & Olsson Contractor

Wildcat


 Ft. from N. Line

330 Ft. from S. Line

 Ft. from E. Line

330 Ft. from W. Line

SW SW NW

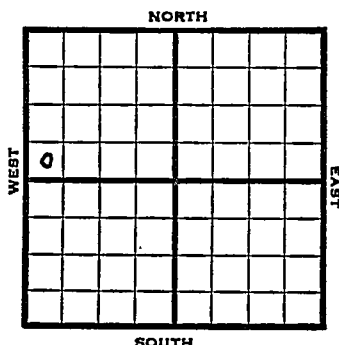

1953

Elev. 1968' REPORT

6/10 Spud 6-9-53

6/24 8" @ 200 w/150
Heeb 3418, Br li 3629, Lans 3646
DST 3766-80, 1 hr., 22' SOCM, 30' gas, 130#
V 4051
DST 4067-75, 1/2 hrs., 12' M, 0#
Simp 4165
Drlg. 4200'

7/1 Spud 6-9-53

D&A

TD 4254

8" @ 200

Heeb 3418, Br lime 3629, Lans 3646

DST 3766-80, opn 1 hr., rec. 22' socm, 30' gas, 130#

Viola 4051

DST 4067-75, opn 1/2 hrs., rec. 12' mud, 0#

Simp 4165, Arb 4224

TD 4254

D&A

County Stafford State Kansas
 Sec. 5 (Blk.) 24 (Sur.) 14W Map No.
 Operator Welch & Olsson Drlg.
 Well No. 1 Farm Koelsch
 Elev. Location SW SW NW

0							

FIRST REPORT

330 Ft. From S Line NW
330 Ft. From W Line Quarter
 1st. Report JUN 10 1953
 Completion
 Remarks
Welch & Olsson - Contr.
 Spudding Date 6-9-53

Drlg. Data Wildcat

J. G. McGEHEE