

(WH7-DC64)✓

Stafford

KANSAS

3

24S

14W

SECTION _____ TOWNSHIP _____ RANGE _____

#1 Davis

WELL NO. _____

Strata Drlg.

COMPANY _____

NORTH

SW SE SW

WEST

EAST

		0					

SOUTH

SEC. **HOT FILE** TWP. **24 S** R. **14 W**

WELL NO. # **1 Davis** FARM

COMPANY **Strata Drlg. Inc.**

CONTRACTOR **Co. tools**


Wildcat

_____ FT. FROM N. LINE

_____ FT. FROM S. LINE

_____ FT. FROM E. LINE

_____ FT. FROM W. LINE

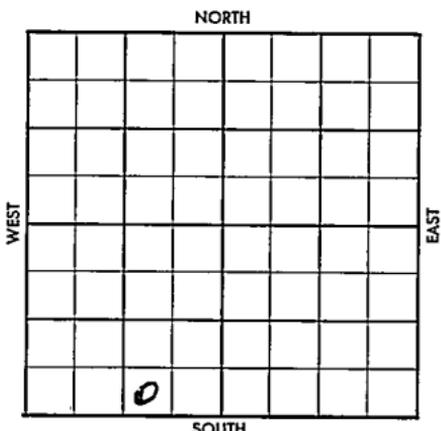

SW SE SW

SDX-DHC-\$3000.00 (Lse S-28154)

1957 ELEVATION **11957' DF** REPORT **(WH7-DC64)** ✓

8/26 Arbuckle Test appx 4300'
To be commenced by November 1, 1957
To be completed by December 1, 1957
(See copy DHC Agrt 8-26-57)

10/16 SDX Grants Time Extension as follows:
To be commenced by Dec. 1, 1957
To be completed by Jan. 1, 1958
(See letter of extension 10-15-57)
4200' Test

11/6 Location (FR Tkt)

12/4 Spud 11-13-57
8-5/8" @ 225/180
Hb 3494', BL 3611', Lsg. 3630',
Viola 3999', C. 3971'
DST 4000-79', 60", Gas in 24", TSTM
rec 30' M. BHP 1400# 20". S. Sh 4145'
Arb. 4211' TD 4240' No test.
D & A (Scout Completion ticket)

ABANDONED

12/11 (Advised Contract Section- D & A) ✓

~~13~~
WILDCAT

S-513-A

CO. ~~Stafford~~ ELEV. SDX
SEC. 3 TWP. 24 RGE. 12W
COMPANY Strata Drigs. NO. 1

OFFSET	
FIRST REPORT	
0	NOV 6 '57

FARM Davis

(WH 7-D 4)

LOC. SW SE SW

GEOL. _____
CONTR. Co. Tools
POOL Wildcat
SPUD _____
Location 4200' test.

CO.
LSE.
NO.
SEC.
TWP.
RGE.

NOV 9 1957

