

KANSAS


Stafford

FORM 51 5M 4-41 PETROL

Section 3 Township 24 Range 15W

Well No. 1-Cornwell "B"

Company Stanolind

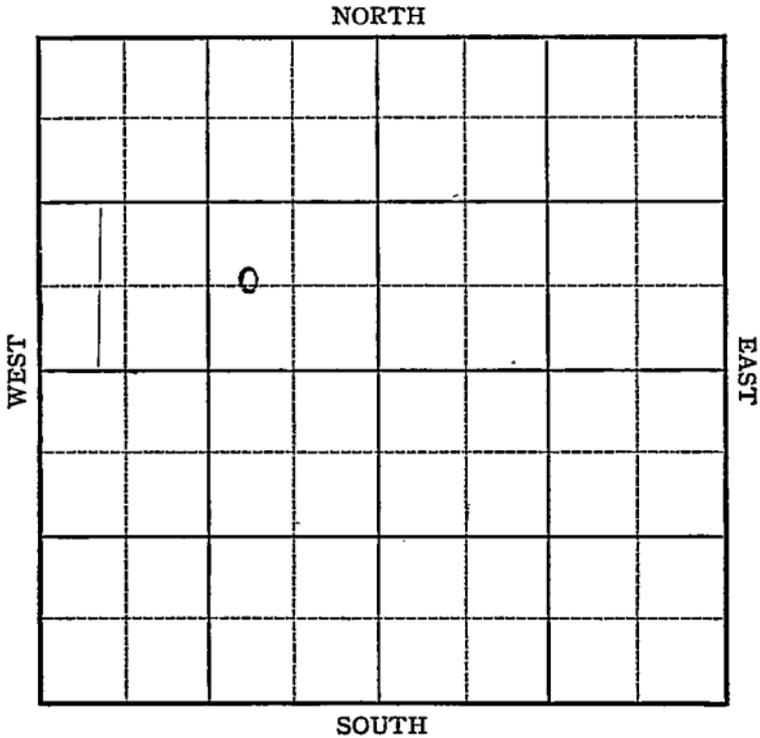

Sec. 3 Twp. 24 R. 15-W

Well No. #1 Connwell "B" Farm

Stanolind Company

(Macksville)


 Ft. from N. Line

660 Ft. from S. Line

990 Ft. from E. Line

 Ft. from W. Line

Elev. 2020

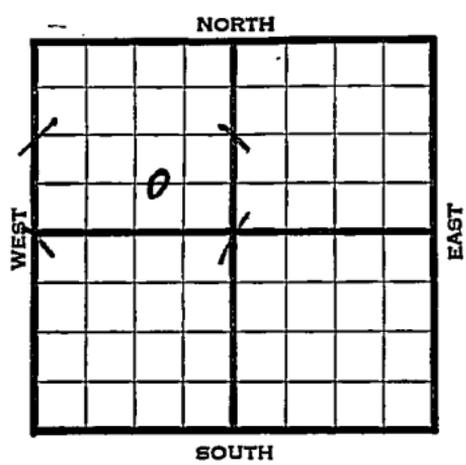

1941	REPORT
------	--------

9/3	Location
-----	----------

9/11	Rotary.
------	---------

9/18	8" - 276' Drlg. 2155'
------	-----------------------

9/25	Lans. 3633' Drlg. 3816'
	No shows.

10/2	Viola 3974' T.D. 4007'
------	------------------------

	No shows. Shut down.
--	----------------------

10/8	Viola 3974'
------	-------------

	T.D. 4007'
--	------------

	No shows.
--	-----------

ABANDONED

Map No. 83 Sec. 3 Twp. 24 R. 15W

Well No. 1 Cornwell "B"

Stanolind Company

LAST REPORT Contractor

SECTION PLAT


C W L SE NW

_____ Ft. from N. Line

660 Ft. from S. Line

990 Ft. from E. Line

_____ Ft. from W. Line

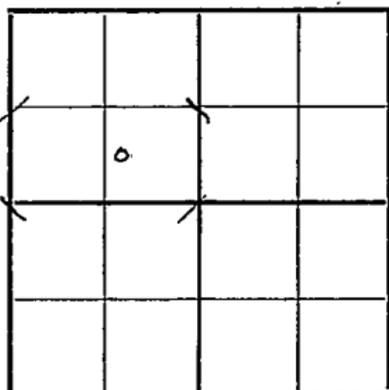

MACKSVILLE POOL

Location X

Rig up _____

Drilling and Remarks:

RECORD

Cased _____ in., _____ ft.

Sand _____

Gas _____

Oil _____

Total Depth _____

PRODUCTION

1st 24 hrs. Nat. _____

1st 24 hrs. after shot _____

Gas _____ Cu. Ft.

Dry Hole _____

Abandoned _____

Date

SEP 3 1941 19

S. J. LEWIS Scout

Stafford

KANSAS

Map No. K-83 Sec. 3 Twp. 24 R. 15WWell No. 1 Cornwell "B"Stanolind CompanyABANDONED Contractor

C W L SE NW

 Ft. from N. Line660 Ft. from S. Line990 Ft. from E. Line Ft. from W. Line

SECTION PLAT

	△		

MACKSVILLE POOL

Location Rig up

Drilling and Remarks:

*Vista 3974**Noshovis*

RECORD

Cased in., ft.Sand Gas Oil Total Depth 4007

PRODUCTION

1st 24 hrs. Nat. 1st 24 hrs. after shot Gas Cu. Ft.Dry Hole Abandoned

Date

OCT 8 1941 19

S. J. LEWIS Scout