

KANSAS

FORM 51 5M 4-41 PETROL


Stafford

Section 3 Township - 24 Range 15-W

Well No. 1 Nagel

Company J. J. Lynn

NORTH Macksville pool

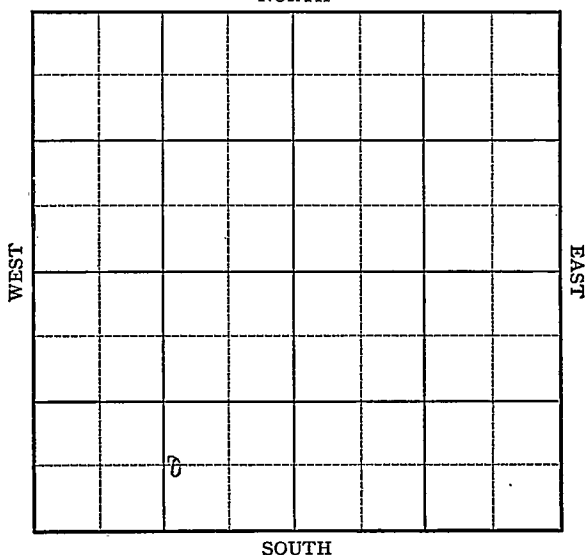

KANSAS


Stafford

Sec. 3 Twp. 24 R. 15-WWell No. #1 Nagel FarmJ. J. Lynn Company

(Macksville)

 Ft. from N. Line660 Ft. from S. Line990 Ft. from E. Line Ft. from W. Line

Elev. 2022

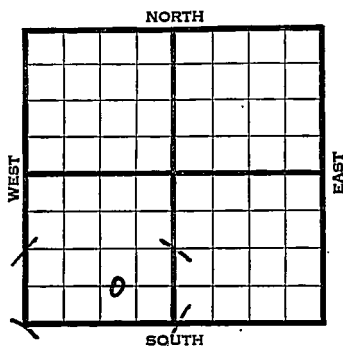

1941

REPORT

9/17 10" - 280' WOC.

9/25 Drlg. 2971'

10/2 Drlg. 3468'

10/9 Lans. 3631' 6" - 3815'

T.D. 3844' RUST.

10/15 Lans. 3631'

6" - 3815'

T.D. 3844'

H.F.W.


ABANDONED

Map No. 83 Sec. 3 Twp. 24 R. 15WWell No. 1 NagelJ. J. Lynn CompanyFIRST REPORT Contractor

C W L SE SW

 Ft. from N. Line660 Ft. from S. Line990 Ft. from E. Line Ft. from W. Line

SECTION PLAT

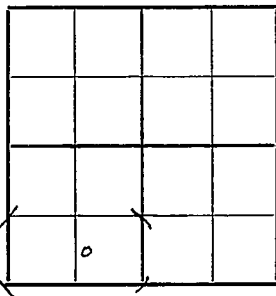

MACKSVILLE POOL

Location Rig up

Drilling and Remarks:

10" - 280'Waiting on
cement to set

RECORD

Cased in., ft.Sand Gas Oil Total Depth

PRODUCTION

1st 24 hrs. Nat. 1st 24 hrs. after shot Gas Cu. Ft.Dry Hole Abandoned

Date

SEP 17 1941 19S. J. LEWIS Scout

Map No. H-83 Sec. 3 Twp. 24 R. 15WWell No. 1 NagelJ. J. Lynn Company

ABANDONED

Contractor

C WL SE SN

 Ft. from N. Line660 Ft. from S. Line990 Ft. from E. Line Ft. from W. Line

MACKSVILLE POOL

SECTION PLAT

D

Location Rig up

Drilling and Remarks:

Lease 36316 " @ 3815HPW.

RECORD

Cased in., ft.Sand Gas Oil Total Depth 2844

PRODUCTION

1st 24 hrs. Nat. 1st 24 hrs. after shot Gas Cu. Ft.Dry Hole Abandoned

Date

OCT 15 1941

19

S. J. LEWIS

Scout