

Sec. 3 Twp. 24 R. 15-W

Well No. #3 NageI Farm

Stanolim Company

(Macksville)


660 Ft. from N. Line

_____ Ft. from S. Line

_____ Ft. from E. Line

990 Ft. from W. Line

Elev. 2019

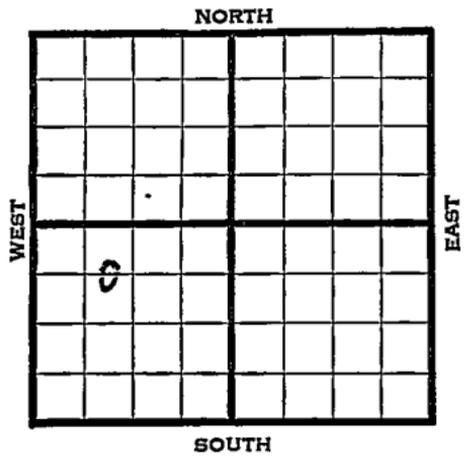

1941

REPORT

10/1 Location

10/9 8" - 270' Drlg. 1640'

10/16 Drlg. 2683'

10/23 Drlg. 2800'

10/30 Drlg. 3635'

11/6 Lans. 3650' Viola 4006'

Drlg. 4025' No shows.

11/12 Arb. 4131'

T.D. 4150'

No shows.

ABANDONED

Map No. K-83 Sec. 3 Twp. 24 R. 15W

Well No. 3 Nagel

Stanolind Company

ABANDONED Contractor

C EL NW SW

660 Ft. from N. Line

_____ Ft. from S. Line

_____ Ft. from E. Line

990 Ft. from W. Line

MACKSVILLE POOL

SECTION PLAT

Location _____

Rig up _____

Drilling and Remarks:

Cr 84/131
No shows

RECORD

Cased _____ in., _____ ft.

Sand _____

Gas _____

Oil _____

Total Depth 4150

PRODUCTION

1st 24 hrs. Nat. _____

1st 24 hrs. after shot _____

Gas _____ Cu. Ft.

Dry Hole _____

Abandoned _____

Date

NOV 12 1941 19

S. J. LEWIS Scout